LAND CORNER RECORDATION CERTIFICATE
Filing Requirement of Act 74, Mich. P.A. 1970

For corners in
CLARE
(County)

	Located In:	Corner Code ##
1. Public Land Survey	T 20N R 5W	D-1, E-1
	T ___ R ___	
	T ___ R ___	
	T ___ R ___	
2. Property Controlling	S 5 T ___ R ___	1, 7
in Section	S ___ T ___ R ___	
3. Miscellaneous	S ___ T ___ R ___	
Property in Sec.	S ___ T ___ R ___	

Register of Deeds Stamp & File Number

4. Lot No. _____ , Recorded Plat _____
5. Private Claims _____

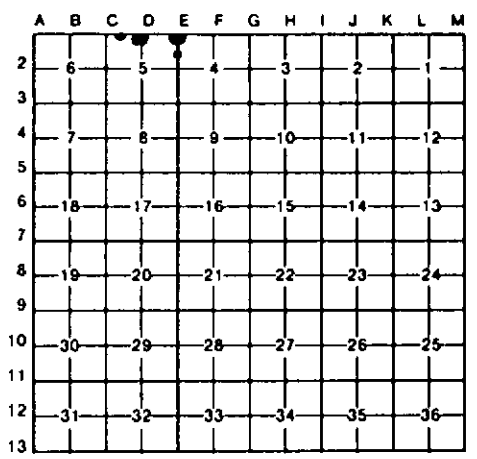

I, CARL F. ROSER, in a field survey on JULY 5, 19 90, do hereby certify that under requirements of P.A. 74, Michigan P.A. of 1970, the corner points mentioned in lines 1 and 2 above were in conformance with regulations and rules therefore as required in the current manual of survey instructions of the United States Department of the Interior, Bureau of Land Management or by a decree of a Court of Law and/or that the corner points mentioned in lines 3, 4 and 5 above were in conformance with the rules of the Michigan Board of Land Surveyors or by a Decree of a Court of Law; established, re-established, monumented, re-monumented, recovered, found as expressed below:

NOTE: Not more than 4 corners, all in the same town and range, may be recorded on this certificate.

A. Description of original monument and accessories and/or subsequent restoration:

D-1 E-1 1 7

B. Description of corner evidence found and/or method applied in restoring or reestablishing corner:

D-1
SET 1" PIPE FOR N 1/4 COR OF SEC 5 (T20N-R5W) ON LINE BETWEEN FD S 1/4 COR SEC 32 (T21N-R5W) & ESTABLISHED SE COR SEC 32 (T21N-R5W), SAID COR'S FROM PREV DEPT SURVEY (PROJ 31-93120, 1983 TO 1987), AND MIDWAY BETWEEN FOUND NE & NW COR'S SEC 5 (T20N-R5W).

E-1
FD M. SCHAAF PIPE FOR NW COR SEC 4. CTR OF WINDING E-W DRIVEABLE TRAIL IS NORTH 359'±5'. K.J. OSTLING FD THIS COR IN 1962 DEPT SURVEY WITH BOTH U.S. BT STUMPS IN PLACE AND ONE CO. SURVEYOR JOHNSON NBT STUMP.

1
ESTABLISHED NE COR OF FRL NW 1/4 OF FRL NW 1/4 OF SEC 5 PER STANDARD BLM INSTRUCTIONS. RUN-OUT SEC. COR PER PROP-MEAS TO GLO PLAT.

7
ESTABLISHED SE COR OF FRL N 1/2 OF FRL NE 1/4 OF SEC 5 PER STANDARD BLM INSTRUCTIONS. COR FALLS AT S EDGE SMALL (100'± DIA.) WET HOLE & AT W EDGE NEW CLEARCUT.

C. Description of monument for corner and accessories established to perpetuate locating the position of the corner:

D-1
PUSHED IN 1" X 96" GALV PIPE W/ALUM CAP; SET CED POST.

6" CEDAR	N10°E	6.7'
9" CEDAR	S85°E	4.2'
5" CEDAR	S10°E	7.3'
5" CEDAR	N65°W	9.1'

E-1
DROVE 1" X 36" GALV PIPE W/ALUM DNR CAP IN FD 1 1/2" PIPE; SET CED POST.

6" MAPLE (CLP 4)	N35°W	18.9'
17" W PINE	DUE E	34.6'
27" W PINE	S25°E	19.9'
5" OAK	S75°W	43.6'

1
PUSHED IN 1" X 96' GALV PIPE W/RLS CAP; SET CED POST W/LOC TAG.

11" CEDAR	DUE E	44.2'
9" CEDAR	S10°W	32.2'
8" TW CEDAR	S72°W	45.0'
6" CEDAR	N35°E	16.7'

7
DROVE 3/8" X 4' GALV PIPE W/RLS CAP, SET CED POST W/LOC TAG.

6" MAPLE	N80°W	5.5'
6" MAPLE	N40°E	16.0'
3" MAPLE	S30°E	22.3'
4" MAPLE	S25°W	13.8'

Signed by Carl F. Roser 5-22-92 Date _____

Surveyor's Michigan License No. 12028

STATE OF MICHIGAN
CARL F. ROSER
LAND SURVEYOR
No. 12028
REGISTERED LAND SURVEYOR

FORM APPROVED BY MICHIGAN STATE BOARD OF LAND SURVEYORS, JAN. 28, 1971
REVISED MAY 14, 1975
REVISED JAN., 1983