LAND CORNER RECORDATION CERTIFICATE
Filing Requirement of Act 74, Mich. P.A. 1970

For corners in CLARE (County)

	Located In:	Corner Code ##
1. Public Land Survey	T 20N R 5W	B-11, C-10
	T ___ R ___	
	T ___ R ___	
	T ___ R ___	
2. Property Controlling	S 29 T ___ R ___	3
in Section	S ___ T ___ R ___	
3. Miscellaneous	S ___ T ___ R ___	
Property in Sec.	S ___ T ___ R ___	

Register of Deeds Stamp & File Number

4. Lot No. _____ , Recorded Plat _____
5. Private Claims _____

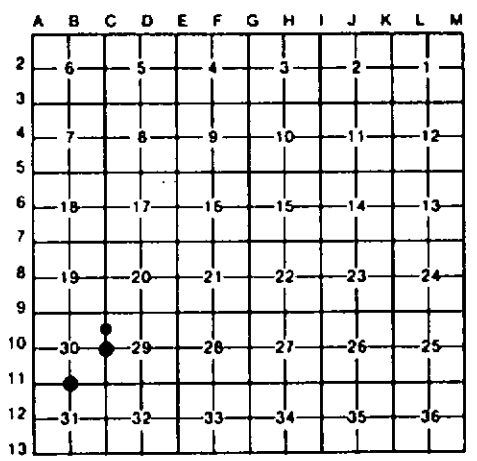

I, CARL F. ROSER, in a field survey on NOVEMBER 5, 19 91, do hereby certify that under requirements of P.A. 74, Michigan P.A. of 1970, the corner points mentioned in lines 1 and 2 above were in conformance with regulations and rules therefore as required in the current manual of survey instructions of the United States Department of the Interior, Bureau of Land Management or by a decree of a Court of Law and/or that the corner points mentioned in lines 3, 4 and 5 above were in conformance with the rules of the Michigan Board of Land Surveyors or by a Decree of a Court of Law; established, re-established, monumented, re-monumented, recovered, found as expressed below:

NOTE: Not more than 4 corners, all in the same town and range, may be recorded on this certificate.

A. Description of original monument and accessories and/or subsequent restoration:

B-11
C-10
3

B. Description of corner evidence found and/or method applied in restoring or reestablishing corner:

B-11
REESTABLISHED S 1/4 COR SEC 30 SINGLE PROPORTION TO U.S.(GLO, RUN-OUT SEC). CTR OF E-W SAND RD IS 48'N. FD RR SPIKE N09°E, 44.57'.

C-10
RESET E 1/4 COR OF SEC 30 FROM (3) FOUND L.S. P. LAPHAM 1983 WITS. COR FALLS AT EAST EDGE OF N-S DIRT RD. DROVE 5/8"x 34" REROD (ON SEC LINE) W/LS CAP N00°21'W, 264.00'.

3
FD 1/2" REROD FOR NW COR OF SW 1/4 OF NW 1/4 OF SEC 29. CTR 26' WIDE N-S DIRT RD IS 11'W. FD REROD BELIEVED TO HAVE BEEN SET IN PREVIOUS SURVEY BY RLS. PAUL LAPHAM.

C. Description of monument for corner and accessories established to perpetuate locating the position of the corner:

B-11
SET DNR MON & CED POST.

5" J PINE	N30°W	2.6'
6" J PINE	N60°E	6.7'
14" B OAK	S75°E	40.2'
21' B OAK	S15°W	30.5'

C-10
DROVE 1/2"x 30" REROD.

+12" R PINE	N75°W	46.00'
+17" TW B OAK	N15°E	27.90'
10" R PINE	N80°E	23.18'
+18" B OAK	S25°E	8.15'

DROVE 5/8"X34" REROD W/RLS CAP & SET CED POST W/LOC TAG S89°56'W 33.0'

+= RLS, P. LAPHAM WITS.

3
FD 1/2" REROD.

8" R PINE	N65°W	60.1'
10" R PINE	N45°E	43.8'
13" R PINE	S80°E	21.5'

SET CED POST W/LOC TAG BESIDE FD 1/2" PIPE EAST 33'

STATE OF MICHIGAN
CARL F. ROSER
LAND SURVEYOR
No. 12028
REGISTERED LAND SURVEYOR

Signed by Carl F. Roser Date 8-10-92

Surveyor's Michigan License No. 12028

FORM APPROVED BY MICHIGAN STATE BOARD OF LAND SURVEYORS, JAN. 28, 1971
REVISED MAY 14, 1975
REVISED JAN., 1983