

LAND CORNER RECORDATION CERTIFICATE
Filing Requirement of Act 74, Mich. P.A. 1970

For corners in
CLARE

(County)	Located in:	Corner Code #/
1. Public Land Survey	T <u>20N</u> R <u>5W</u>	<u>B-13, C-12</u>
	T _____ R _____	<u>C-13</u>
	T _____ R _____	_____
	T _____ R _____	_____
	T _____ R _____	_____
2. Property Controlling in Section	S _____ T _____ R _____	_____
	S _____ T _____ R _____	_____
3. Miscellaneous Property in Sec.	S _____ T _____ R _____	_____
	S _____ T _____ R _____	_____


Register of Deeds Stamp & File Number

4. Lot No. _____, Recorded Plat _____
5. Private Claims _____

I, CARL F. ROSER, in a field survey on NOVEMBER 5, 19 91, do hereby certify that under requirements of P.A. 74, Michigan P.A. of 1970, the corner points mentioned in lines 1 and 2 above were in conformance with regulations and rules therefore as required in the current manual of survey instructions of the United States Department of the Interior, Bureau of Land Management or by a decree of a Court of Law and/or that the corner points mentioned in lines 3, 4 and 5 above were in conformance with the rules of the Michigan Board of Land Surveyors or by a Decree of a Court of Law; established, re-established, monumented, re-monumented, recovered, found as expressed below:

NOTE: Not more than 4 corners, all in the same town and range, may be recorded on this certificate.

A. Description of original monument and accessories and/or subsequent restoration:
B-13 C-12 C-13

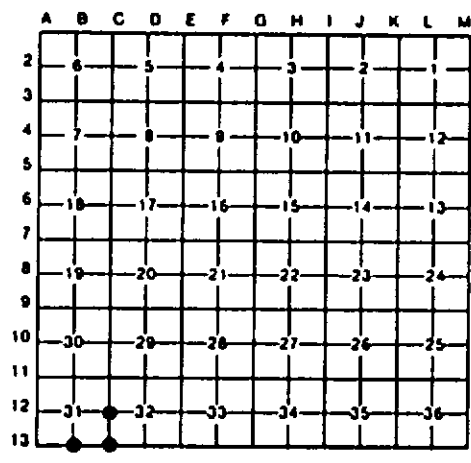


B. Description of corner evidence found and/or method applied in restoring or reestablishing corner:

B-13	C-12	C-13
FD PIPE BY H. SCHAAF, 1941. SCHAAF SET PIPE FROM N. PINE STP REMAINS NE WITH "PORTION OF LOWER FACE PLAINLY VISIBLE" THAT HE SAYS WAS GLO.	REESTABLISHED W 1/4 COR SEC 32 MIDWAY & ON LINE BETWEEN SEC COR'S 1/2 MILE N & S. CTR OF N-S SAND ROAD IS 32' WEST.	RESTORED SW COR OF SEC 32 FROM (4) H. SCHAAF (RLS & DEPT FORESTRY CHIEF) 1941 NBT'S: (3 STP REMAINS & ONE LIVE B OAK.) SCHAAF NOTES INDICATE HE HAD ORIG EVIDENCE HERE. CTR N-S SAND ROAD IS 40'± E.

C. Description of monument for corner and accessories established to perpetuate locating the position of the corner:

B-13	C-12	C-13
FD 1 1/2" PIPE; ADDED DNR MON & SET CED POST. 2" N PINE N15°N 9.6' 2" N PINE N35°E 28.7' 3" N PINE S75°E 11.8' 10" B OAK S60°N 20.3'	DROVE 1" X 65" GALV PIPE W/ALUM DNR CAP; SET CED POST. 2" B OAK NORTH 17.7' 3" MAPLE N25°E 20.1' 4" J PINE S80°E 29.1' 9" J PINE S15°N 12.2'	SET DNR MON & CED POST. FD 1/2" REROD W/RLS CAP "J". S.#18664" N78°51'E 62.74' ±20" B OAK NORTH 16.7' 3" TW B OAK S75°E 5.1' 7" B OAK S30°W 25.0' 2" N PINE S70°N 44.5'

*MARCUS SCHAAF WIT.

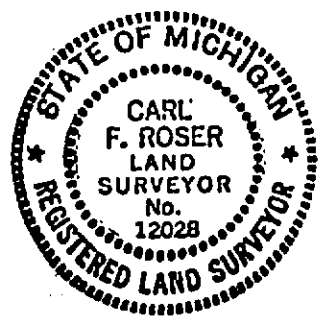

Signed by Carl F. Roser 12028 Date 8-10-92
Surveyor's Michigan License No. _____