

LAND CORNER RECORDATION CERTIFICATE
Filing Requirement of Act 74, Mich. P.A. 1970


For corners in
CLARE
 (County)

Located In: _____ Corner Code ~~##~~ _____

- | | | |
|------------------------------------|--------------------------|--------------------|
| 1. Public Land Survey | T <u>20N</u> R <u>5W</u> | <u>E-13, F-13,</u> |
| | T _____ R _____ | <u>B-13</u> |
| | T _____ R _____ | _____ |
| | T _____ R _____ | _____ |
| 2. Property Controlling in Section | S _____ T _____ R _____ | _____ |
| | S _____ T _____ R _____ | _____ |
| 3. Miscellaneous Property in Sec. | S _____ T _____ R _____ | _____ |
| | S _____ T _____ R _____ | _____ |

Register of Deeds Stamp & File Number

4. Lot No. _____, Recorded Plat _____
 5. Private Claims _____

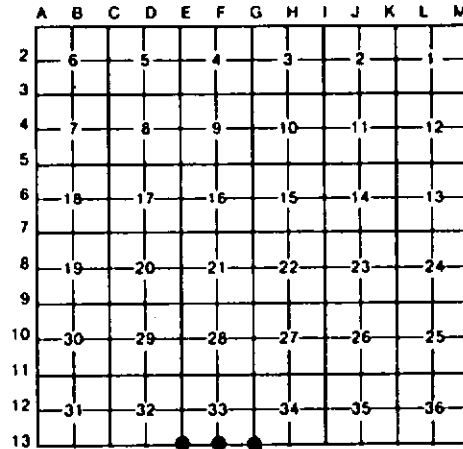

I, CARL F. ROSE, in a field survey on MAY 8, 19 91, do hereby certify that under requirements of P.A. 74, Michigan P.A. of 1970, the corner points mentioned in lines 1 and 2 above were in conformance with regulations and rules therefore as required in the current manual of survey instructions of the United States Department of the Interior, Bureau of Land Management or by a decree of a Court of Law and/or that the corner points mentioned in lines 3, 4 and 5 above were in conformance with the rules of the Michigan Board of Land Surveyors or by a Decree of a Court of Law; established, re-established, monumented, re-monumented, recovered, found as expressed below:

NOTE: Not more than 4 corners, all in the same town and range, may be recorded on this certificate.

A. Description of original monument and accessories and/or subsequent restoration:


E-13 F-13 6-13 6-13

B. Description of corner evidence found and/or method applied in restoring or reestablishing corner:

<p>E-13 ACCEPTED FD 1/2" REROD W/LS PAUL LAPHAM CAP #9433. FOR SW COR S-33. DROVE FD 3/4" X 18" GALV PINCH PIPE (FD LYING DOWN IN VICINITY) 1' DEEP ON NE EDGE OF FD 1/2" REROD. THIS COR FITS RECORDED SURVEY IN NE 1/4 OF S-5, T19N-R5E. THIS COR ALSO FITS 3 FD IRONS (330' APART) ON S LINE OF SW OF SW OF S-33. CTR N-S DIRT RD IS 6' WEST.</p>	<p>F-13 MONUMENTED THE S 1/4 COR S-33 MIDWAY & ON LINE BETWEEN FD SW & SE COR S-33. COR FALLS IN SW EDGE OF 13" ASH STUMP. CTR OLD E-W BUILT UP TRAIL IS 17' SOUTH.</p>	<p>6-13 *SEE ACT. 74, P.A. 1970 COR REC #64-72 AT REG DEEDS AND CERT SUR'S. L.1-PGS 289 & 291 (1972) AND CERT SUR'S. L.1 - P.944 & L.2-P.61 (1975). SOME DATA IS REVERSED FROM THAT FD ON GROUND PLUS SOME BUM BRG'S. FD & ACCEPTED 3/4" IR ROD FOR SEC COR COMM TO SEC'S 33 & 34 (T20N-R5W) AND SEC'S 3 & 4 (T19N-R5W); FITS ABOVE NOTED (CONTINUED)</p>	<p>6-13 (*B* CONTINUED) (AND RECORDED) CERT OF SURVEYS. SEE WORKING DRAWING (DNR PROJ #31-93135) FOR ADDITIONAL FD IRONS. THE GRAVEL RD TO S & E IS NOT CENTERED ON FD 3/4" ROD. THE FD 3/4" ROD IS CENTERED ON OLD (NOT DRIVABLE) 2-TRACK TO NORTH AND WEST. GR. Rd (in Curve) is S45°E 32E.</p>
---	--	--	---

C. Description of monument for corner and accessories established to perpetuate locating the position of the corner:

<p>E-13 FD 1/2" REROD W/LS CAP. #8" R PINE N40°W 45.27' 3" R PINE N10°E 71.41' #4" J PINE S55°E 38.69' 4" W PINE S70°W 38.29' FD 1/2" REROD W/LS CAP WEST 33.0'</p>	<p>F-13 DROVE 1" X 70" GALV PIPE W/ ALUM DNR CAP & SET CED POST. 4" MAPLE N25°W 24.6' 8" CEDAR N35°E 58.0' 6" MAPLE S25°E 31.2' 6" ASH S80°W 12.9'</p>	<p>6-13 RECOV'D 3/4" IR ROD. SET CED POST W/LOC TAG N10°E 33'. #12" J PINE N30°E 20.98' #10" J PINE N34°W 34.86' 5" ST GATE POST (N'LY POST-E FACE) N78°W 59.50' DROVE SQ HEAD RR NAIL (#54) IN P.P. S50°W 54.45' #FD HEALED OVER NAIL AND DROVE 30 P.SPK.</p>
---	---	--

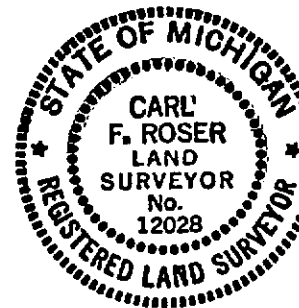

*WIT BY OTHERS.
 Signed by Carl F. Roser 12028 Date 8-10-92