LAND CORNER RECORDATION CERTIFICATE

Filing Requirement of Act 74, Mich. P.A. 1970

For corners in CLARE (County)

	Located In:	Corner Code ##
1. Public Land Survey	T 20N R 5W	J-9, K-8
	T ___ R ___	K-9
	T ___ R ___	
	T ___ R ___	
2. Property Controlling	S 26 T ___ R ___	5
in Section	S ___ T ___ R ___	
3. Miscellaneous	S ___ T ___ R ___	
Property in Sec.	S ___ T ___ R ___	

Register of Deeds Stamp & File Number

4. Lot No. _____ , Recorded Plat _____
5. Private Claims _____

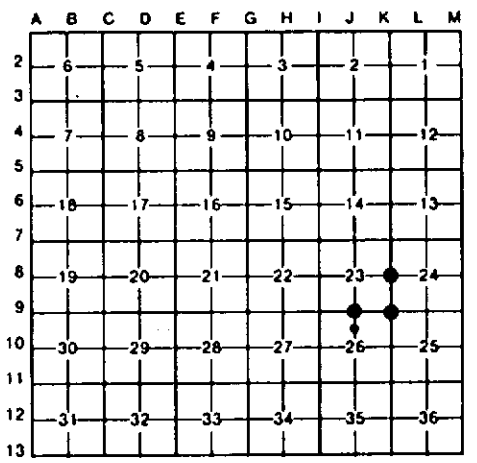

I, CARL F. ROSER, in a field survey on MAY 3, 19 91, do hereby certify that under requirements of P.A. 74, Michigan P.A. of 1970, the corner points mentioned in lines 1 and 2 above were in conformance with regulations and rules therefore as required in the current manual of survey instructions of the United States Department of the Interior, Bureau of Land Management or by a decree of a Court of Law and/or that the corner points mentioned in lines 3, 4 and 5 above were in conformance with the rules of the Michigan Board of Land Surveyors or by a Decree of a Court of Law; established, re-established, monumented, re-monumented, recovered, found as expressed below:

NOTE: Not more than 4 corners, all in the same town and range, may be recorded on this certificate.

A. Description of original monument and accessories and/or subsequent restoration:

J-9	K-8	K-9	5

B. Description of corner evidence found and/or method applied in restoring or reestablishing corner:

J-9	K-8	K-9	5
REESTABLISHED N 1/4 COR S-26 MIDWAY & ON LINE BETWEEN FD NE COR & FD (GET COR FROM FD M. SCHAAF WITS) NW COR S-26. CTR OLD RR GRADE (RUNS NW-SE) IS EAST 111'±.	ACCEPTED FD 1/2" REROD FOR E 1/4 COR S-23 AS RECORDED BY RLS PAUL LAPHAM IN 1977. CTR N-S BIT RD IN CURVE IS 50'W.	ACCEPTED THIS 1/2" REROD FOR SE COR S-23. RLS PAUL LAPHAM RECORDED THIS COR IN 1977. COR IS IN INTERSEC OF N-S B.TOP & GRAVEL RD EAST.	ESTABLISHED SW COR OF NW 1/4 OF NE 1/4 OF S-26 PER STANDARD BLM INSTRUCTIONS. (PROPER SUBDIVISION OF SECTION). NE'LY EDGE OF CEDAR, BALSAM, MAPLE SWAMP IS 5'±N AND 15'±7'E.

C. Description of monument for corner and accessories established to perpetuate locating the position of the corner:

J-9	K-8	K-9	5
SET DNR MON & CED POST.	FD 1/2" IR ROD; ADDED DNR MON & CED POST.	FD 1/2" REROD IN MON BOX.	DROVE 3/8" X 5' GALV PIPE W/RLS CAP & SET CED POST W/LOC TAG.
9" TWIN R PINE N70°W 31.7'	*7" W OAK N65°E 41.79'	*10" OAK N40°W 53.85'	6" MAPLE N12°W 19.9'
17" B.OAK N40°W 20.4'	*8" W OAK S30°E 23.04'	*16" B OAK S75°W 36.75'	10" SPRUCE N10°E 11.7'
10" R.PINE N05°E 36.8'	*7" W OAK S20°W 19.19'	14" B OAK N50°E 85.65'	9" CEDAR S15°E 8.7'
12" R.PINE S50°E 15.3'	FD CONC MON S89°44'31'W 84.37'	7" R PINE S40°E 94.00'	8" CEDAR S82°W 13.8'
	4" W PINE N35°E 29.71'	SET CED POST W/ LOC TAG. WEST 33'	
	*RLS PAUL LAPHAM WIT.	*RLS PAUL LAPHAM WIT.	

Signed by Carl F. Roser 12028 8-10-92 Date _____

Surveyor's Michigan License No. _____

STATE OF MICHIGAN CARL F. ROSER LAND SURVEYOR No. 12028 REGISTERED LAND SURVEYOR

FORM APPROVED BY MICHIGAN STATE BOARD OF LAND SURVEYORS, JAN. 28, 1971 REVISED MAY 14, 1975 REVISED JAN., 1983