

LAND CORNER RECORDATION CERTIFICATE
Filing Requirement of Act 74, Mich. P.A. 1970

For corners in
CLARE
 (County)

Located In: _____ Corner Code D-9

- | | | | | | |
|------------------------------------|---|------------|---|-----------|------------|
| 1. Public Land Survey | T | <u>20N</u> | R | <u>5W</u> | <u>D-9</u> |
| | T | _____ | R | _____ | _____ |
| | T | _____ | R | _____ | _____ |
| | T | _____ | R | _____ | _____ |
| 2. Property Controlling in Section | S | _____ | T | _____ | R |
| | S | _____ | T | _____ | R |
| 3. Miscellaneous Property in Sec. | S | _____ | T | _____ | R |
| | S | _____ | T | _____ | R |

Register of Deeds Stamp & File Number

4. Lot No. _____, Recorded Plat _____
 5. Private Claims _____

	A	B	C	D	E	F	G	H	I	J	K	L	M
2	6		5		4		3		2		1		
3													
4	7		8		9		10		11		12		
5													
6	16		17		16		15		14		13		
7													
8	19		20		21		22		23		24		
9													
10	30		29		28		27		26		25		
11													
12	31		32		33		34		35		36		
13													

I, CARL F. ROSER, in a field survey on MAY 5, 19 92, do hereby certify that under requirements of P.A. 74, Michigan P.A. of 1970, the corner points mentioned in lines 1 and 2 above were in conformance with regulations and rules therefore as required in the current manual of survey instructions of the United States Department of the Interior, Bureau of Land Management or by a decree of a Court of Law and/or that the corner points mentioned in lines 3, 4 and 5 above were in conformance with the rules of the Michigan Board of Land Surveyors or by a Decree of a Court of Law; established, re-established, monumented, re-monumented, recovered, found as expressed below:

NOTE: Not more than 4 corners, all in the same town and range, may be recorded on this certificate.

A. Description of original monument and accessories and/or subsequent restoration:


D-9	D-9 CONT.
(*B* CONT.) 1/4 LINE OF SEC 20; THE WEST LINE OF "HOWARD HEIGHTS SUB'N NO.3", RECORDED SUB. (1973), BY L.S. P.LAPHAM, BEING WITH-IN 1 FOOT OF SAID N-S 1/4 LINE OF SEC 20. ON 4-3-91, FD 1/2" x 12" PINCH PIPE, THAT IS S84°00'E, 9.17' FROM ABOVE (CONT. TO RIGHT)	NOTED FD 1/2" PIPE FOR S1/4 COR. OF SEC 20. THE 1/2" x 12" PINCH PIPE WAS INADVERTENTLY HIT AND RECORDED, PER ACT 74, PA 1970, FILING NO.441-83, BY L.S. P.LAPHAM, DATED 4-20-83; CREW PROBABLY FD WRONG IR 9.2' EAST WHEN WITNESSING FOR 1/4 COR TO SEC'S (CONT. BELOW)

B. Description of corner evidence found and/or method applied in restoring or reestablishing corner:

D-9	D-9 CONT.
ON 11-4-91, FD BELOWNOTED 1/2" PIPE FOR S1/4 COR OF SEC 20. ALSO FD 1/8 COR 1/4 MILE N & SEC COR 1/2 MILE N FROM PREVIOUS SURVEY FOR NW1/4 OF NW1/4 OF S-29, BY L.S. P.LAPHAM; ABOVE NOTED FD 1/2" PIPE FITS ON LINE & DBL DIST. ACROSS SAID FD 1/8 COR & SAID FD SEC COR TO WEST. ABOVE NOTED FD 1/2" PIPE (S1/4 S-20) ALSO FITS N-S (CONT. ABOVE)	20 & 29. CTR OF E-W DIRT RD IS 6' SOUTH.

C. Description of monument for corner and accessories established to perpetuate locating the position of the corner:

D-9	D-9 CONT.
FD 1/2" x 18" PINCH PIPE, ADDED 5/8" x 34" REROD W/L.S. CAP.	
9"R.PINE	N60°W 50.73'
12"R.PINE	N25°W 29.22'
SM COR CADIN	N35°E 122.9'
*32"B.OAK	N55°E 32.76'
*20"TW.B.OAK	S10°W 30.16'
SET CED POST W/TAG SOUTH 33'	
* L.S. P.LAPHAM WIT.	

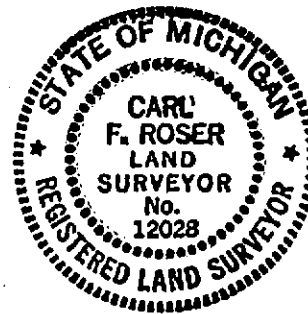

Signed by Carl F. Roser 12028 Date 8-10-92

Surveyor's Michigan License No. _____