LAND CORNER RECORDATION CERTIFICATE

Filing Requirement of Act 74, Mich. P.A. 1970

For corners in CLARE (County)

	Located In:	Corner Code ##
1. Public Land Survey	T 20N R 5W	B-9, C-8
	T ___ R ___	C-9
	T ___ R ___	
	T ___ R ___	
2. Property Controlling	S ___ T ___ R ___	
in Section	S ___ T ___ R ___	
3. Miscellaneous	S ___ T ___ R ___	
Property in Sec.	S ___ T ___ R ___	

Register of Deeds Stamp & File Number

4. Lot No. _____ , Recorded Plat _____
5. Private Claims _____

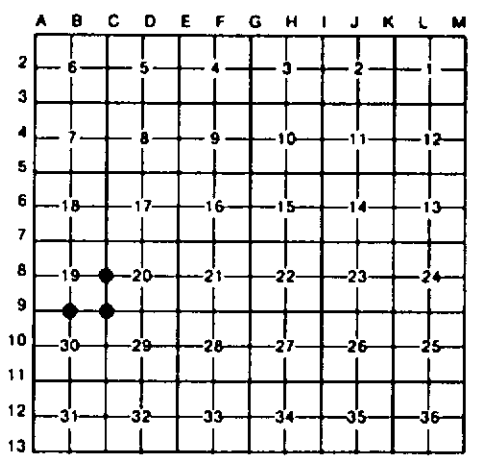

I, CARL F. ROSER, in a field survey on NOVEMBER 6, 19 91, do hereby certify that under requirements of P.A. 74, Michigan P.A. of 1970, the corner points mentioned in lines 1 and 2 above were in conformance with regulations and rules therefore as required in the current manual of survey instructions of the United States Department of the Interior, Bureau of Land Management or by a decree of a Court of Law and/or that the corner points mentioned in lines 3, 4 and 5 above were in conformance with the rules of the Michigan Board of Land Surveyors or by a Decree of a Court of Law; established, re-established, monumented, re-monumented, recovered, found as expressed below:

NOTE: Not more than 4 corners, all in the same town and range, may be recorded on this certificate.

A. Description of original monument and accessories and/or subsequent restoration:

B-9

C-8

C-9

B. Description of corner evidence found and/or method applied in restoring or reestablishing corner:

B-9

REESTAB'D 1/4 COR COMM TO SEC'S 19 & 30, ON LINE BETWEEN FD NE & NW COR'S OF S-30, AND AT PROP. MEASURE TO GLO SURVEY (RUN-OUT SEC). JCT OF CLEARED OUT LANE (3 WHEELER OR JEEP TRAIL) WEST & SOUTH IS 31'± N AND 33'± WEST.

C-8

FD & ACCEPTED 2" PIPE FOR 1/4 COR COMM TO SEC'S 19 & 20; 2" PIPE BELIEVED TO HAVE BEEN SET BY MARCUS SCHAAF IN 1941 FROM REMAINS OF BOTH USBT'S (Y. PINE STUMP REMAINS). APPROX CTR OF N-S GAS TRANSMISSION LINE IS 312'± WEST. CTR OF E-W TRAIL IS 21'± SOUTH.

C-9

FD MALE END OF SUCKER ROD FOR SW COR S20. THIS COR FITS FD 2 LLS P. LAPHAM, 1983 WITS. CTR RD LOOKING TO E IS 4'N. CTR RD LOOKING TO S IS 3'W. CTR TRAIL N'LY IS 14'± W.

C. Description of monument for corner and accessories established to perpetuate locating the position of the corner:

B-9

SET DNR MON & CED POST.

6" R PINE	N10°W	5.9'
5" R PINE	N75°E	19.2'
6" R PINE	S35°E	19.5'
5" R PINE	S15°E	8.8'
E-W RANDOM LINE	NORTH	15'

C-8

DROVE 1" X 60' GALV PIPE W/ ALUM DNR CAP IN FD OLD 2" PIPE & SET CED POST W/LOC TAG.

5" R PINE	N80°W	46.7'
9" B OAK	S65°E	19.0'
5" R PINE	S35°W	37.3'
10" R PINE	S60°W	49.9'

C-9

FD 1" ROD (THREADED END OF SUCKER ROD).

*15" R PINE	N60°W	49.60'
12" R PINE	N15°E	28.43'
*10" J PINE	N60°E	51.95'
11" TW R PINE	S50°W	55.21'

*1983 WIT BY L.S. PAUL LAPHAM.

STATE OF MICHIGAN
CARL F. ROSER
LAND SURVEYOR
No. 12028
REGISTERED LAND SURVEYOR

Signed by Carl F. Roser 12028 Date 8-10-92

Surveyor's Michigan License No. _____

FORM APPROVED BY MICHIGAN STATE BOARD OF LAND SURVEYORS, JAN. 28, 1971
REVISED MAY 14, 1975
REVISED JAN., 1983