LAND CORNER RECORDATION CERTIFICATE
Filing Requirement of Act 74, Mich. P.A. 1970

For corners in
CLARE
(County)

	Located In:	Corner Code ##
1. Public Land Survey	T 20N R 5W	E-6, E-7
	T ___ R ___	
	T ___ R ___	
	T ___ R ___	
2. Property Controlling	S 20 T ___ R ___	2
in Section	S 16 T ___ R ___	11
3. Miscellaneous	S ___ T ___ R ___	
Property in Sec.	S ___ T ___ R ___	

Register of Deeds Stamp & File Number

4. Lot No. _____ , Recorded Plat _____
5. Private Claims _____

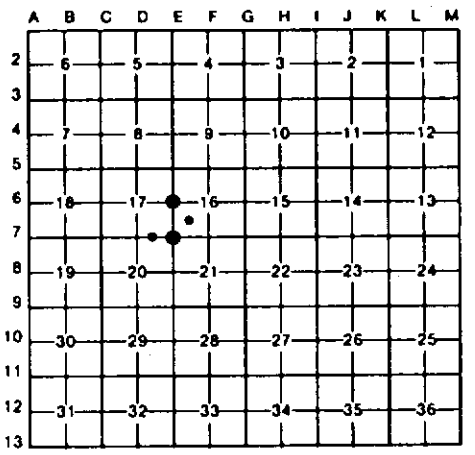

I, CARL F. ROSER, in a field survey on NOVEMBER 7, 19 91, do hereby certify that under requirements of P.A. 74, Michigan P.A. of 1970, the corner points mentioned in lines 1 and 2 above were in conformance with regulations and rules therefore as required in the current manual of survey instructions of the United States Department of the Interior, Bureau of Land Management or by a decree of a Court of Law and/or that the corner points mentioned in lines 3, 4 and 5 above were in conformance with the rules of the Michigan Board of Land Surveyors or by a Decree of a Court of Law; established, re-established, monumented, re-monumented, recovered, found as expressed below:

NOTE: Not more than 4 corners, all in the same town and range, may be recorded on this certificate.

A. Description of original monument and accessories and/or subsequent restoration:

E-6 E-7 2 11

STATE OF MICHIGAN
CARL F. ROSER
LAND SURVEYOR
No. 12028
REGISTERED LAND SURVEYOR

B. Description of corner evidence found and/or method applied in restoring or reestablishing corner:

E-6	E-7	2	11
RECOVERED CONSERVATION DEPT MON FOR N 1/4 COR SEC 16. RLS KEN OSTLING SET MIDPOINT ON LINE IN 1962. CORNER ALSO WITNESSED & USED BY RLS J. WILCOX.	ACCEPTED FD 2" PIPE FOR SW COR SEC 16. IN 1962, RLS KEN OSTLING CONCLUDED THIS 2" PIPE WAS BY CO SURVEYOR ARTHUR JOHNSON IN 1914± AS INDICATED BY CO SURVEY RECORDS AND TESTIMONY OF LOCAL RESIDENTS. K. OSTLING SAID STUMP OF ONE PROBABLE U.S. BT IN PLACE SW. COR IS IN APPROX CTR GRAVEL RD TO S & TRAIL RD TO N. CTR GR RD TO E IS 6'± S.	ESTABLISHED E 1/8 COR ON NORTH LINE OF SEC 20 (THIS IS NOT A GOVT LOT COR IN S-17) MIDWAY & ON LINE BETWEEN N 1/4 COR & NE COR OF SEC 20. CTR WINDING TRAIL IS 34' N. THIS POINT WAS ESTAB'D IN ORDER TO HAVE A MEANINGFUL POINT OF RECORD ON LINE BETWEEN SEC'S 17 & 20.	ESTABLISHED THE CENTER OF SW 1/4 SEC 16 PER STD. BLM INSTRUCTIONS.

C. Description of monument for corner and accessories established to perpetuate locating the position of the corner:

E-6			E-7			2			11		
FD CONSERVATION DEPT MON; ADDED CED POST.			FD 2" PIPE.			DROVE 5/8" X 34" REROD W/RLS CAP & SET CED POST W/LOC TAG.			DROVE 5/8" X 34" REROD W/RLS CAP & SET CED POST W/LOC TAG.		
*18" TW MAPLE	N57°W	29.11'	*19" B OAK			2" W PINE	N45°W	2.2'	11" R PINE	N15°W	36.9'
*18" MAPLE	N63°E	3.86'	IN (CLP 3)	N10°W	15.00'	4" BALSAM	N65°E	9.2'	10" R PINE	N45°E	33.1'
13" MAPLE	S30°E	13.25'	13" B OAK	N57°E	55.68'	2" W PINE	S20°E	6.6'	11" R PINE	S05°W	50.0'
13" MAPLE	S45°W	25.92'	*POWER POLE	S50°W	51.10'	8" B OAK	S30°W	5.2'	CTR GAS WELL		
EDGE MUSKEGON RIVER	S40°E	124'+3'	FD STEEL FN POST W/ PFS SIGN	DUE N	33'				#726	N88°W	62.0'

*RLS K. OSTLING 1962 WIT. *RLS G. FRASER 1976 WIT.

Signed by Carl F. Roser Date 8-10-92

Surveyor's Michigan License No. 12028

FORM APPROVED BY MICHIGAN STATE BOARD OF LAND SURVEYORS, JAN. 28, 1971
REVISED MAY 14, 1975
REVISED JAN., 1983