LAND CORNER RECORDATION CERTIFICATE

Filing Requirement of Act 74, Mich. P.A. 1970

For corners in
CLARE
(County)

	Located In:	Corner Code ##
1. Public Land Survey	T 20N R 5W	F-7
	T ___ R ___	
	T ___ R ___	
	T ___ R ___	
2. Property Controlling	S 16 T ___ R ___	12,13,15
in Section	S ___ T ___ R ___	
3. Miscellaneous	S ___ T ___ R ___	
Property in Sec.	S ___ T ___ R ___	

Register of Deeds Stamp & File Number

4. Lot No. _____ , Recorded Plat _____
5. Private Claims _____

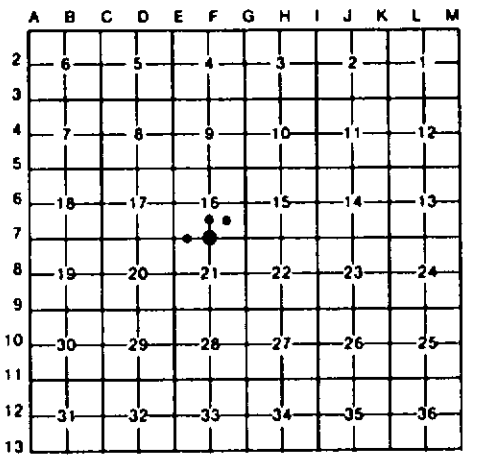

I, CARL F. ROSER , in a field survey on JANUARY 19 , 19 89 , do hereby certify that under requirements of P.A. 74, Michigan P.A. of 1970, the corner points mentioned in lines 1 and 2 above were in conformance with regulations and rules therefore as required in the current manual of survey instructions of the United States Department of the Interior, Bureau of Land Management or by a decree of a Court of Law and/or that the corner points mentioned in lines 3, 4 and 5 above were in conformance with the rules of the Michigan Board of Land Surveyors or by a Decree of a Court of Law; established, re-established, monumented, re-monumented, recovered, found as expressed below:

NOTE: Not more than 4 corners, all in the same town and range, may be recorded on this certificate.

A. Description of original monument and accessories and/or subsequent restoration:

F-7 12 13 15

STATE OF MICHIGAN
CARL F. ROSER
LAND SURVEYOR
No. 12028
REGISTERED LAND SURVEYOR

B. Description of corner evidence found and/or method applied in restoring or reestablishing corner:

F-7	12	13	15
FD 1/2" PIPE (REPLACED W/ 5/8" X 34" REROD) FOR 1/4 COR COMMON TO SEC'S 16 & 21. CENTER E-W GRAVEL ROAD IS 2'± S. NW COR OF CEMETERY FN (FN'S E & S) IS SOUTH, 38.6'.	ACCEPTED FD 1/2" REROD FOR NE COR OF SE 1/4 OF SW 1/4 OF SEC. 16. GOURDIE-FRASER & ASSOC. TRAVERSE CITY, ESTABLISHED THIS COR IN 1976.	ACCEPTED FD 1/2" REROD FOR CTR OF SE 1/4 SEC. 16. GOURDIE-FRASER & ASSOC. TRAVERSE CITY, ESTABLISHED THIS COR IN 1976.	ESTABLISHED SW COR OF SE 1/4 OF SW 1/4 OF SEC. 16. MIDPOINT & ON LINE BETWEEN SW & S 1/4 CORS OF SEC. 16.

C. Description of monument for corner and accessories established to perpetuate locating the position of the corner:

F-7	12	13	15
FD 1/2" X 20" PIPE; REPLACED W/ 5/8" X 34" REROD W/RLS CAP.	FD 1/2" REROD W/RLS CAP; ADDED CED POST W/LOC TAG.	FD 1/2" REROD W/RLS CAP; ADDED CED POST W/LOC TAG.	DROVE 5/8" X 34" REROD W/RLS CAP.
16" R PINE N36°W 52.92'	3" TW W PINE N40°E 62.0'	8" B OAK (CLP 3) N15°W 26.8'	10" OAK N33°W 24.4'
28" TW OAK N04°W 43.28'	13" B OAK S20°E 30.2'	4" W PINE S83°E 82.6'	20" OAK N40°E 31.5'
*POWER POLE S10°W 31.10'	CTR E-W TRAIL DUE S 145'	CTR E-W TRAIL DUE S 104'	14" R PINE S50°E 87.3'
FD IR W/LS CAP #13037 S00°25'W 33.00'	CTR N-S TRAIL DUE W 98'	CTR GAS WELL #791 N70°W 67.6'	SET CED POST W/LOC TAG. DUE N 33'
SET CED POST W/ LOC TAG. NORTH 33'			CTR E-W GR RD SOUTH 6'±1'
*=GOURDIE-FRASER & ASSOC. WIT.			

Signed by Carl F. Roser Date 8-10-92

Surveyor's Michigan License No. 12028

FORM APPROVED BY MICHIGAN STATE BOARD OF LAND SURVEYORS, JAN. 26, 1971
REVISED MAY 14, 1975
REVISED JAN., 1983