LAND CORNER RECORDATION CERTIFICATE

Filing Requirement of Act 74, Mich. P.A. 1970

For corners in CLARE (County)

	Located In:	Corner Code ##
1. Public Land Survey	T 20N R 5W	I-7, J-7,
	T ___ R ___	K-7
	T ___ R ___	
	T ___ R ___	
2. Property Controlling	S 14 T ___ R ___	15
in Section	S ___ T ___ R ___	
3. Miscellaneous	S ___ T ___ R ___	
Property in Sec.	S ___ T ___ R ___	

Register of Deeds Stamp & File Number

4. Lot No. _____ , Recorded Plat _____
5. Private Claims _____

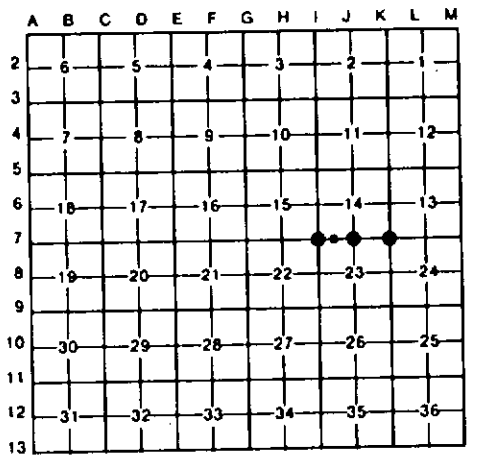

I, CARL F. ROSER, in a field survey on SEPTEMBER 19, 19 90, do hereby certify that under requirements of P.A. 74, Michigan P.A. of 1970, the corner points mentioned in lines 1 and 2 above were in conformance with regulations and rules therefore as required in the current manual of survey instructions of the United States Department of the Interior, Bureau of Land Management or by a decree of a Court of Law and/or that the corner points mentioned in lines 3, 4 and 5 above were in conformance with the rules of the Michigan Board of Land Surveyors or by a Decree of a Court of Law; established, re-established, monumented, re-monumented, recovered, found as expressed below:

NOTE: Not more than 4 corners, all in the same town and range, may be recorded on this certificate.

A. Description of original monument and accessories and/or subsequent restoration:

I-7 J-7 K-7 15

B. Description of corner evidence found and/or method applied in restoring or reestablishing corner:

I-7
ACCEPTED FD 1 1/2" PIPE FOR SE COR S-15 AS RECORDED BY RLS PAUL LAPHAM IN 1971. FD EVIDENCE OF 3 MARCUS SCHAAF 1941 WITS. CTR GR RD IN CURVE IS 76'± 4'S.

J-7
ACCEPTED FD 1/2" REROD IN MON BOX FOR N 1/4 COR S-23. CTR E-W BIT RD IS 1' NORTH. FITS THREE (1977) PAUL LAPHAM WITS.

K-7
ACCEPTED FD SUCKER ROD FOR SW COR S-13. RLS PAUL LAPHAM RECORDED THIS COR IN 1971. FD OLD R/W FN REMAINS E'LY 28'± 3'N. CTR E-W TRAIL IS 6'± S.

15
FD REROD FOR SW COR OF SE 1/4 OF SW 1/4 OF S-14. FD TOP 1/2 OF REROD BENT. REPLACED IN EXACT SAME POSITION W/ 5/8" X 17" REROD THAT FIT VERY CLOSE TO MIDWAY AND ON LINE BETWEEN SW & S 1/4 COR OF S-14. CTR BIT RD IS 1'N.

C. Description of monument for corner and accessories established to perpetuate locating the position of the corner:

I-7
FD 1 1/2" PIPE & STEEL FN POST; ADDED CED POST W/LOC TAG.

*8" B OAK	N30°E	35.90'
8" B OAK	N60°E	9.58'
7" B OAK	S60°W	29.95'
*9" B OAK	N85°W	24.03'

*LLS P. LAPHAM WITS.

J-7
FD 1/2" REROD IN MON BOX.

6" R PINE	N40°W	53.86'
*18" OAK	NORTH	34.57'
*12" W OAK	S50°E	63.48'
11" OAK	S60°W	65.11'
SET CED POST W/ LOC TAG.	SOUTH	33'

*RLS P. LAPHAM WITS.

K-7
FD MALE END 3/4" SUCKER ROD.

*6" TW W OAK	N30°W	26.03'
7" W PINE	N15°W	39.09'
2" MAPLE	N55°E	42.02'
8" OAK	S55°E	38.15'

*RLS PAUL LAPHAM WIT.

15
FD 1/2" REROD; REPLACED WITH 5/8" X 17" REROD W/RLS CAP.

12" R PINE	N05°W	83.7'
10" R PINE	N60°E	87.4'
3" OAK	S50°E	65.5'
SET CED POST W/ LOC TAG	SOUTH	33'

Signed by Carl F. Roser 12028 Date 8-10-92

Surveyor's Michigan License No. _____

STATE OF MICHIGAN CARL F. ROSER LAND SURVEYOR No. 12028 REGISTERED LAND SURVEYOR

FORM APPROVED BY MICHIGAN STATE BOARD OF LAND SURVEYORS, JAN. 28, 1971 REVISED MAY 14, 1975 REVISED JAN., 1983