RECEIVED
E ☑ I ☐ A ☐
51-94
94 NOV 28 AM 10: 37

REGISTER OF DEEDS
CLARE COUNTY
DONNA M CARR

LAND CORNER RECORDATION CERTIFICATE

Filing Requirement of Act 74, Mich. P.A. 1970

For corners in

CLARE (County)

	Located In:	Corner Code ##
1. Public Land Survey	T 20N R 6W	A-7
	T ___ R ___	
	T ___ R ___	
	T ___ R ___	
2. Property Controlling	S ___ T ___ R ___	
in Section	S ___ T ___ R ___	
3. Miscellaneous	S ___ T ___ R ___	
Property in Sec.	S ___ T ___ R ___	

Register of Deeds Stamp & File Number

4. Lot No. _____ , Recorded Plat _____
5. Private Claims _____

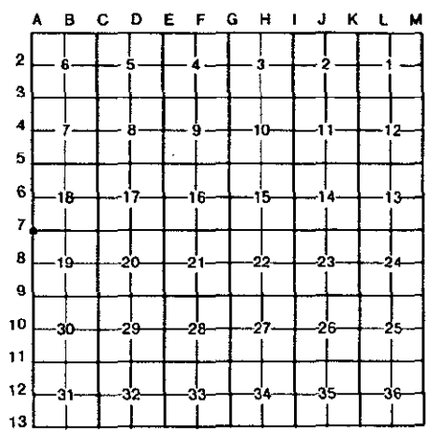

I, MARK R. ROBISON, in a field survey on NOVEMBER, 19 94, do hereby certify that under requirements of P.A. 74, Michigan P.A. of 1970, the corner points mentioned in lines 1 and 2 above were in conformance with regulations and rules therefore as required in the current manual of survey instructions of the United States Department of the Interior, Bureau of Land Management or by a decree of a Court of Law and/or that the corner points mentioned in lines 3, 4 and 5 above were in conformance with the rules of the Michigan Board of Land Surveyors or by a Decree of a Court of Law; established, re-established, monumented, re-monumented, recovered, found as expressed below:

NOTE: Not more than 4 corners, all in the same town and range, may be recorded on this certificate.

A. Description of original monument and accessories and/or subsequent restoration:

1838 NICHOLSON, G.L.O. PG.524
POST
WIT.-(1)BEECH 10" S44°W 63 LKS.
(2)BEECH 10" N47°W 51 LKS.

11-29-07 A. JOHNSON, C.S.R. L.4-PG.130
WIT.-(3)BEECH 8" N42°E 100 LKS.
(4)FENCE POST 8" SOUTH 50 LKS.

8-24-78 WILCOX, L.C.R.C. #338
1" IRON ROD
WIT.(4)S10°W CORNER FENCE POST 33.67'
(5)N85°E POWER POLE 162.73'
(6)S45°W 10" MAPLE 43.41'

5-30-79 WILCOX, L.C.R.C. #368
1" IRON ROD
WIT.-(4) (5) & (6) ABOVE

B. Description of corner evidence found and/or method applied in restoring or reestablishing corner:

FOUND 1"x29" IRON SHAFT IN ASPHALT PAVEMENT. EXCAVATED TO 3'. FOUND NO OTHER EVIDENCE. FOUND WITNESSES #4,5, & 6.

APPROVED LAND CORNER
P.A. 345 of 1990
Clare County
Chairman Paul B. Fopham
Date Nov. 23, 1994

This Corner established in Clare County Remonumentation Program.

See dossier for detailed report.

C. Description of monument for corner and accessories established to perpetuate locating the position of the corner:

SET 5/8" X 36" RE-ROD WITH 3" CLARE COUNTY MONUMENT CAP IN MONUMENT BOX.
WITNESSES:
N77°E 162.50' POWER POLE - NAIL & TAG (5)
S83°E 103.66' 16" APPLE - NAIL & TAG
S15°W 33.67' 7" FENCE POST - NAIL & TAG (4)
S75°W 118.82' 18" MAPLE - NAIL & TAG

STATE OF MICHIGAN
MARK R. ROBISON
PROFESSIONAL SURVEYOR
No. 27458
LICENSED PROFESSIONAL SURVEYOR

Signed by Mark R. Robison Date 11-23-94

Surveyor's Michigan License No. 27458

FORM APPROVED BY MICHIGAN STATE BOARD OF LAND SURVEYORS, JAN. 28, 1971
REVISED MAY 14, 1975
REVISED JAN., 1983