RECEIVED
E ☑ I ☐ A ☐
#56-94
94 NOV 28 AM 10: 37

REGISTER OF DEEDS
CLARE COUNTY
DONNA M CARR

LAND CORNER RECORDATION CERTIFICATE
Filing Requirement of Act 74, Mich. P.A. 1970

For corners in CLARE (County)

	Located In:	Corner Code #
1. Public Land Survey	T 20N R 6W	C-7
	T ___ R ___	
	T ___ R ___	
	T ___ R ___	
2. Property Controlling	S ___ T ___ R ___	
in Section	S ___ T ___ R ___	
3. Miscellaneous	S ___ T ___ R ___	
Property in Sec.	S ___ T ___ R ___	

Register of Deeds Stamp & File Number

4. Lot No. _____, Recorded Plat _____
5. Private Claims _____

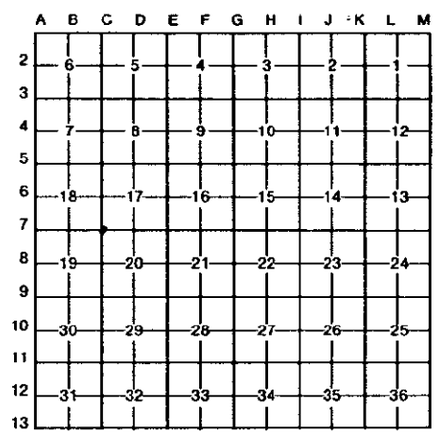

I, MARK R. ROBISON, in a field survey on NOVEMBER, 19 94, do hereby certify that under requirements of P.A. 74, Michigan P.A. of 1970, the corner points mentioned in lines 1 and 2 above were in conformance with regulations and rules therefore as required in the current manual of survey instructions of the United States Department of the Interior, Bureau of Land Management or by a decree of a Court of Law and/or that the corner points mentioned in lines 3, 4 and 5 above were in conformance with the rules of the Michigan Board of Land Surveyors or by a Decree of a Court of Law; established, re-established, monumented, re-monumented, recovered, found as expressed below:

NOTE: Not more than 4 corners, all in the same town and range, may be recorded on this certificate.

A. Description of original monument and accessories and/or subsequent restoration:

1856 COLEMAN, G.L.O. PG.530
POST
WIT.-(1)LYNN 8" N76°W 12 LKS.
(2)HEMLOCK 8" S65 1/2°E 26 LKS.

11-29-07 A. JOHNSON, C.S.R. L.4-PG.130
WIT.-(3)PINE STUMP 36" S60°E 81 1/2 LKS.

JULY 1942 C.S.R. L.2-PG.123
LARGE STONE BROKEN CROCKERY
WIT.-(4)BOULDER N30°E
(5)POWER POLE SW 35.4'
(6)NW CORNER OF HOUSE SE 99.65'

NO RECORDED SURVEYS

8-24-78 WILCOX L.C.R.C. #338
RE-ROD
WIT.-(7)TELE. POLE S40°W 41.22'
(6)FOUNDATION S35°E 99.65'
(8)FENCE POST N75°E 81.15'

B. Description of corner evidence found and/or method applied in restoring or reestablishing corner:

FOUND 1/2"x18" IRON WITH SURVEYORS CAP. EXCAVATED TO 3'. FOUND NO OTHER EVIDENCE. FOUND WITNESSES #6,7, & 8. ASPHALT SURFACE.

APPROVED LAND CORNER
P.A. 345 of 1990
Clare County
Chairman Paul A. Lyphen
Date Nov 23, 1994

This Corner established in Clare County Remonumentation Program.

See dossier for detailed report.

C. Description of monument for corner and accessories established to perpetuate locating the position of the corner:

SET 5/8" X 36" RE-ROD WITH 3" CLARE COUNTY MONUMENT CAP IN MONUMENT BOX.
WITNESSES:
N43°E 114.06' 8" ELM (CLUSTER OF 4) - NAIL & TAG
S70°E 195.34' 35" APPLE TREE - NAIL & TAG
N72°E 81.05' 6" FENCE POST - NAIL & TAG (8)
S42°W 41.14' POWER POLE - NAIL & TAG (7)

STATE OF MICHIGAN
MARK R. ROBISON
PROFESSIONAL SURVEYOR
No. 27458
LICENSED PROFESSIONAL SURVEYOR

Signed by Mark R. Robison Date 11-23-94
Surveyor's Michigan License No. 27458

FORM APPROVED BY MICHIGAN STATE BOARD OF LAND SURVEYORS, JAN. 28, 1971
REVISED MAY 14, 1975
REVISED JAN., 1983