

CLARE County Remonumentation  
**LAND CORNER RECORDATION CERTIFICATE**  
 Filing Requirement of Act 74, Mich. P.A. 1970

For corners in

CLARE Located in: Corner Code #  
 (County)

1. Public Land Survey T20N R06W H-13  
 T19N R06W H-1  
 T R  
 T R  
 2. Property Controlling S T R  
 in Section S T R  
 3. Miscellaneous S T R  
 Property in Sec. S T R

REC'D  
 #291-98  
 98 NOV 18 AM 9:56  
 REGISTER OF DEEDS  
 CLARE COUNTY  
 CAROL A. McAULAY

Register of Deeds Stamp & File Number

4. Lot No. \_\_\_\_\_, Recorded Plat \_\_\_\_\_  
 5. Private Claims \_\_\_\_\_

I, Mark R Robison, in a field survey on May 26, 1998 do hereby state that under requirements of P.A. 74, Michigan P.A. of 1970, the corner points mention in lines 1 and 2 above were in conformance with regulations and rules therefore as required in the current manual of survey instructions of the United States Department of the Interior, Bureau of Land Management or by a decree of a Court of Law and/or that the corner points mentioned in lines 3, 4 and 5 above were in conformance with the rules of the Michigan Board of Land Surveyors or by a Decree of a Court of Law; established, re-established, monumented, recovered, found as expressed below:

A	B	C	D	E	F	G	H	I	J	K	L	M
1												
2	6	5	4	3	2	1						
3												
4	7	8	9	10	11	12						
5												
6	18	17	16	15	14	13						
7												
8	19	20	21	22	23	24						
9												
10	30	29	28	27	26	25						
11												
12	31	32	33	34	35	36						
13												

**NOTE: Not more than 2 corners, all in the same town and range, may be recorded on this certificate**

This is a single corner common to T20N, R06W  
 H-13 and T19N, R06W H-1

A. Description of original monument and accessories and/or subsequent restoration:

H-13: 1838 Nicholson  
 Set 1/4 Sec Post  
 Wit-Maple 12" N20E 14  
 Maple 16 N17W 15

1856 Coleman  
 Wit-Hemlock 14 N56E 29  
 Y. Pine 12 N26W 117  
 Note: Coleman resurveyed from S 1/4 Sec 33 to Meander Post on W. Side river in Sec 34.  
 12-15-76 Ostling LCRC#277&Plat of Survey  
 Set corner at squared tree believed to be previously used by Gourdie-Fraser in survey of Section 3 & conforms generally to U.S. Notes to swamps, etc.  
 Set DNR Mon  
 Wit-N68E 20.6 20" W. Pine  
 S20E 17.15 6" R. Oak

9-15-92 Gourdie-Fraser File Drawing  
 Fd DNR Monument  
 Wit-N70E 20.93 20" W. Pine  
 N40E 35.10 12" R. Pine  
 N20W 16.02 16" Oak  
 S30E 17.44 8" Oak

**SURVEY &  
 REMONUMENTATION**

**NOV 25 1998**

**SECTION**

B. Description of corner evidence found and/or method applied in restoring or reestablishing corner:


H-13: Found DNR Monument and both witnesses. Found three 1992 witnesses.

See dossier for detailed report.

C. Description of monument for corner and accessories established to perpetuate locating the position of the corner:

H-13: Accepted DNR Monument as Clare County Remonumentation Monument. Accepted as best available evidence of the accepted position of the corner.

Witnesses:  
 N68E 21.35, nail & tag, 28" W. Pine (OBT)  
 S20E 17.38, nail & tag, 12" R. Oak (OBT)  
 N15W 16.12, nail & tag, 20" Twin Oak (OBT)  
 N82W 22.48, nail & tag, 18" R. Oak

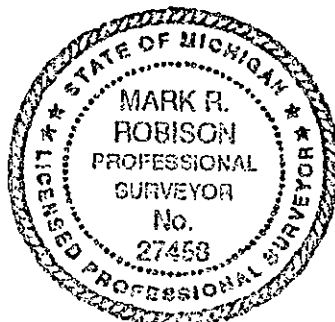

APPROVED LAND CORNER  
 P.A. 345 of 1990  
 Clare County

Chairman Paul H. Leph  
 Date 9-8-98

Signed by Mark R. Robison  
 Surveyor's Michigan License No. 27458

Date 11-16-98