

CLARE County Remonumentation

LAND CORNER RECORDATION CERTIFICATE **RECEIVED**
 Filing Requirement of Act 74, Mich. P.A. 1970

For corners in

_____ CLARE _____ Located in: _____ Corner Code # _____
 (County)

1. Public Land Survey T20N R06W J-13
 T19NR06W J-1
 T _____ R _____
 T _____ R _____

2. Property Controlling S _____ T _____ R _____
 in Section S _____ T _____ R _____

3. Miscellaneous S _____ T _____ R _____
 Property in Sec. S _____ T _____ R _____

293-98
 98 NOV 18 AM 9:57
 REGISTER OF DEEDS
 CLARE COUNTY
 CAROL A. MAULAY

Register of Deeds Stamp & File Number

4. Lot No. _____, Recorded Plat _____
 5. Private Claims _____

I, Mark R Robison, in a field survey on May 28, 1998 do hereby state that under requirements of P.A. 74, Michigan P.A. of 1970, the corner points mention in lines 1 and 2 above were in conformance with regulations and rules therefore as required in the current manual of survey instructions of the United States Department of the Interior, Bureau of Land Management or by a decree of a Court of Law and/or that the corner points mentioned in lines 3, 4 and 5 above were in conformance with the rules of the Michigan Board of Land Surveyors or by a Decree of a Court of Law; established, re-established, monumented, recovered, found as expressed below:

| | | | | | | | | | | | | | |
|----|---|----|---|----|---|----|---|----|---|----|---|----|---|
| 1 | A | B | C | D | E | F | G | H | I | J | K | L | M |
| 2 | | 6 | | 5 | | 4 | | 3 | | 2 | | 1 | |
| 3 | | | | | | | | | | | | | |
| 4 | | 7 | | 8 | | 9 | | 10 | | 11 | | 12 | |
| 5 | | | | | | | | | | | | | |
| 6 | | 18 | | 17 | | 16 | | 15 | | 14 | | 13 | |
| 7 | | | | | | | | | | | | | |
| 8 | | 19 | | 20 | | 21 | | 22 | | 23 | | 24 | |
| 9 | | | | | | | | | | | | | |
| 10 | | 30 | | 29 | | 28 | | 27 | | 26 | | 25 | |
| 11 | | | | | | | | | | | | | |
| 12 | | 31 | | 32 | | 33 | | 34 | | 35 | | 36 | |
| 13 | | | | | | | | | | | | | |

NOTE: Not more than 2 corners, all in the same town and range, may be recorded on this certificate

This is a single corner common to T20N, R06W
 J-13 and T19N, R06W J-1

A. Description of original monument and accessories and/or subsequent restoration:
 J-13: 1838 Nicholson
 W. Pine 12" for 1/4 Section Post

12-15-76 Ostling LCRC#273&Plat of Survey
 Set by proportionate measurement, MPOL,
 between section corners. Matches up
 generally with old fence East & South.
 Nothing for previous corner.
 Set DNR Mon & red-top Post
 Wit-N73E 40.4 11" Oak
 S04E 19.0 4" Oak


**SURVEY &
 REMONUMENTATION**
 NOV 25 1998
 SECTION

B. Description of corner evidence found and/or method applied in restoring or reestablishing corner:
 J-13: Found DNR Monument and both witnesses. The 4" Oak was dead.

See dossier for detailed report.

C. Description of monument for corner and accessories established to perpetuate locating the position of the corner:
 J-13: Accepted DNR Monument as Clare County Remonumentation Monument. Accepted as best available evidence of the proper method of re-establishment of the Corner.

Witnesses:
 N73E 40.40', nail & tag, 16" Oak (OBT)
 S13E 34.43', nail & tag, 12" Oak
 N27E 10.02', nail & tag, 9" J. Pine
 S49W 17.78', nail & tag, 9" J. Pine

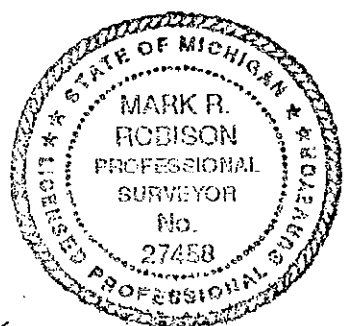

APPROVED LAND CORNER
 P.A. 345 of 1990
 Clare County
 Chairman Paul S. Loph
 Date 9-22-98

Signed by Mark R. Robison
 Surveyor's Michigan License No. 27458

Date 11-16-98