

LAND CORNER RECORDATION CERTIFICATE

FILING REQUIREMENT OF ACT 74, MICH. P.A.1970

FOR CORNERS OF--:	LOCATED IN--:	CORNER CODE NUMBER
1. PUBLIC LAND SURVEY _____	T. 20 N. R. 6 W. ●	M-4; M-5; M-7
2. PROPERTY CONTROLLING IN SECTION _____	T. _____ N. S., R. _____ E. W.	_____
3. MISCELLANEOUS PROPERTY IN SECTION _____	T. _____ N. S., R. _____ E. W.	_____
4. LOT NO. _____, RECORDED PLAT _____		
5. PRIVATE CLAIMS _____		

REGISTER OF DEEDS STAMP AND FILING NUMBER

I, Kenneth J. Ostling, do hereby certify that under requirements of P.A. 74, Michigan P.A. of 1970, the corner points mentioned in lines 1 and 2 above were, in a field survey on June 25, 1976, established, re-established, monumented, re-monumented, recovered or restored as expressed below and in conformance with regulations and rules therefore as required in the current manual of survey instructions of the United States Department of the Interior, Bureau of Land Management or by a decree of a court of law. Furthermore, that the corner points mentioned in lines 3, 4 and 5 above were, in a field survey on _____, 19____, found, recovered, restored, established or re-established as expressed below and in conformance with the rules of the Michigan State Board of Registration for Land Surveyors or, by a Decree of a Court of law:

A. Description of original monument and accessories and/or subsequent restoration:
 B. (continued)

M-7 Found 3/4" iron bar as established by unknown surveyor which fits road intersection and appears to have been accepted as the corner. Also found old stake point below road surface from witnesses recorded in county surveyor's office, said point being about 6.2' north of the iron bar. Believe the iron bar more readily located and accepted as the corner in local surveys.


B. Description of corner evidence found and/or method applied in restoring or re-establishing corner:

M-4 Set corner by proportionate measurement, midpoint on line, between section corners. Unable to locate a previous corner although a possible witness of record might place corner about 15' north. Did not consider this sufficient evidence to restore corner & create inequitable half miles.

M-5 Found 1 1/2" pipe at road intersection, apparently used in a survey of Sec. 12 by Consumers Power Co. and possibly others. Also found another iron bar about 10' NW, of undetermined origin and can find no record. Does not fit with C.P. Co. survey of Section 12.

C. Description of monument for corner and accessories established to perpetuate locating the position of the corner:

M-4	M-5	M-7
Set DNR monument	Set DNR mon. in place of pipe	Set DNR monument
12" W. Oak N75°E 49.6	6" Oak S77°W 47.50	12" R. Oak N64°E 66.5
4" Ash S60°E 14.85	7" Oak N66°W 69.0	24" R. Pine N28°W 164.75
Cedar Post East 12'	1" Iron Bar N10°W 10.37	

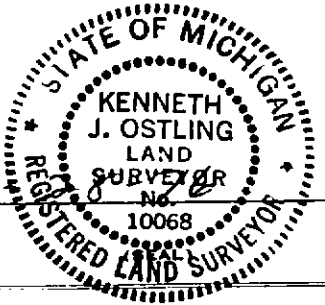

SIGNED BY Kenneth Ostling

DATE 7

SURVEYOR'S MICHIGAN REGISTRATION NO. 10068

FOR STATE AND UNITED STATES AGENCIES:

SIGNED BY _____ DATE _____
CHIEF OF SURVEY PARTY

APPROVED AND SIGNED BY _____ DATE _____
MICHIGAN REGISTERED LAND SURVEYOR

(SEAL)

SURVEYOR'S MICHIGAN REGISTRATION NO. _____ CLARE COUNTY