LAND CORNER RECORDATION CERTIFICATE

Filing Requirement of Act 74, Mich. P.A. 1970

For corners in CLARE (County)

	Located In:	Corner Code ##
1. Public Land Survey	T 20N R 6W	G-5
	T ___ R ___	G-6
	T ___ R ___	H-5
	T ___ R ___	
2. Property Controlling	S 10 T ___ R ___	16
in Section	S ___ T ___ R ___	
3. Miscellaneous	S ___ T ___ R ___	
Property in Sec.	S ___ T ___ R ___	

Register of Deeds Stamp & File Number

4. Lot No. _____ , Recorded Plat _____
5. Private Claims _____

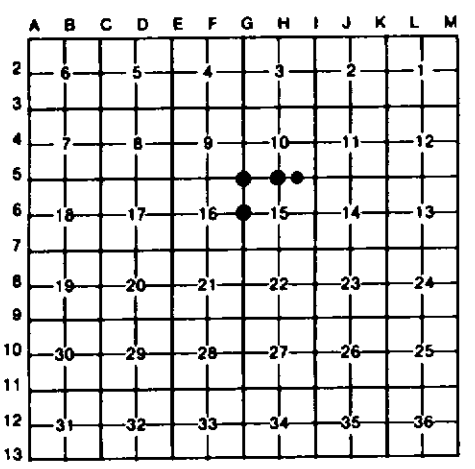

I, CARL F. ROSER, in a field survey on SEPTEMBER 29, 19 87, do hereby certify that under requirements of P.A. 74, Michigan P.A. of 1970, the corner points mentioned in lines 1 and 2 above were in conformance with regulations and rules therefore as required in the current manual of survey instructions of the United States Department of the Interior, Bureau of Land Management or by a decree of a Court of Law and/or that the corner points mentioned in lines 3, 4 and 5 above were in conformance with the rules of the Michigan Board of Land Surveyors or by a Decree of a Court of Law; established, re-established, monumented, re-monumented, recovered, found as expressed below:

NOTE: Not more than 4 corners, all in the same town and range, may be recorded on this certificate.

A. Description of original monument and accessories and/or subsequent restoration:

G-5: G-6: H-5: 16

B. Description of corner evidence found and/or method applied in restoring or reestablishing corner:

G-5
FD IRON FOR NW COR SEC 15. COR IS RLS, M.MCCLUNG 1974 COR OF RECORD. FD M.M. P.POLE WIT AND STP OF BT; BOTH FIT OK. COR IS BURIED ABOUT 6", IN APPROX CTR N-S BIT RD. DEPT. SURVEYOR, KEN OSTLING HERE IN 1975.

G-6
FD IRON FOR N1/4 SEC 15. COR WAS REESTABLISHED BY RLS M.MCCLUNG IN 1974. DEPT SURVEYOR, KEN OSTLING, WAS HERE IN 1975. CORNER FALLS IN CTR OF N-S BIT SURFACE ROAD.

H-5
ACCEPTED FD IRON IN PIPE FOR S1/4 SEC 10. RLS, M.MCCLUNG REMONUMENTED THIS COR IN 1974 FROM CO SURVEYOR, A.JOHNSON 1906 COR OF RECORD; (RECORDED AT REGISTER OF DEEDS, VOL 4 - PG 61). FD CONIFER STP REMAINS, FITS A.J. RECORD. FD BOTH M.M. WITS, FIT OK. DEPT. SURVEYOR, KEN OSTLING, WAS HERE IN 1975.

16
ACCEPTED FD IRON FOR SW COR OF SE 1/4,SE 1/4 OF SEC 10. COR IS RLS K.J.OSTLING 1976 COR OF RECORD.

C. Description of monument for corner and accessories established to perpetuate locating the position of the corner:

G-5

FD RLS CAP IN THREADED END OF 3/4" SUCKER ROD.		
3" TO 12" MAPLES,		
CLUMP OF 7	S65°W	79.65'
19" R.OAK	DUE N	75.32'
FN COR(N-S)	N35°W	55.57'
POWER POLE	S85°E	69.20'
SET CED POST W/LOC TAG	DUE N	33'

G-6

FD RLS CAP ON THREADED END OF 3/4" SUCKER ROD.		
10" ASH	S45°W	44.3'
* 42" BEECH	N85°W	47.4'
* 22" WALNUT	N20°W	132.8'
FN COR (N-S)	DUE N	33'

* = RLS M.MCCLUNG WIT.

H-5

FD RLS CAP IN THREADED END OF SUCKER ROD, IN 2" PIPE.		
9" MAPLE	N25°W	5.6'
9" W.OAK	N20°W	13.2'
4" HEMLOCK	S60°W	10.5'
* 12" MAPLE	N65°W	6.8'
OLD FN COR(N-S-W)	DUE S	35'
E-W POWER LINE	DUE S	44'

* = RLS M.MCCLUNG WIT.

16

FD 5/8"x 36" HEX IRON; ADDED RLS CAP. FD CED POST W/LOC TAG		
5" W BIRCH(CLP 2)	N80°E	27.7'
7" R.OAK	S70°E	42.1'
6" B.CHEERY	S30°W	13.4'
CTR E-W DIRT RD	DUE S	37'±2'

Signed by Carl F. Roser 3-30-89 Date _____

Surveyor's Michigan License No. 12028

STATE OF MICHIGAN CARL F. ROSER LAND SURVEYOR No. 12028 REGISTERED LAND SURVEYOR

FORM APPROVED BY MICHIGAN STATE BOARD OF LAND SURVEYORS JAN. 14, 1975 REVISED JAN., 1983