LAND CORNER RECORDATION CERTIFICATE

Filing Requirement of Act 74, Mich. P.A. 1970

For corners in CLARE (County)

	Located In:	Corner Code ##
1. Public Land Survey	T 20N R 6W	1-5
	T ___ R ___	1-6
	T ___ R ___	1-7
	T ___ R ___	
2. Property Controlling	S 22 T ___ R ___	2
in Section	S ___ T ___ R ___	
3. Miscellaneous	S ___ T ___ R ___	
Property in Sec.	S ___ T ___ R ___	

Register of Deeds Stamp & File Number

4. Lot No. _____ , Recorded Plat _____
5. Private Claims _____

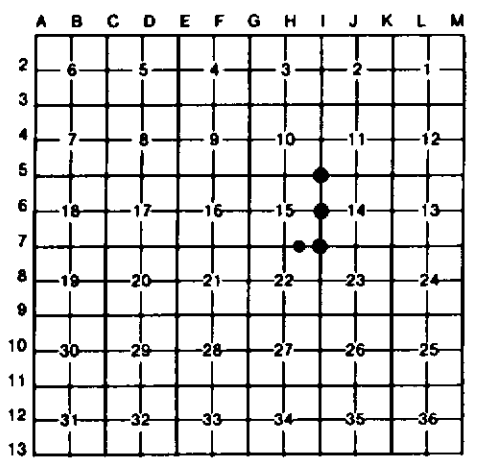

I, CARL F. ROSER, in a field survey on SEPTEMBER 29, 19 87, do hereby certify that under requirements of P.A. 74, Michigan P.A. of 1970, the corner points mentioned in lines 1 and 2 above were in conformance with regulations and rules therefore as required in the current manual of survey instructions of the United States Department of the Interior, Bureau of Land Management or by a decree of a Court of Law and/or that the corner points mentioned in lines 3, 4 and 5 above were in conformance with the rules of the Michigan Board of Land Surveyors or by a Decree of a Court of Law; established, re-established, monumented, re-monumented, recovered, found as expressed below:

NOTE: Not more than 4 corners, all in the same town and range, may be recorded on this certificate.

A. Description of original monument and accessories and/or subsequent restoration:

1-5	1-6	1-7	2

B. Description of corner evidence found and/or method applied in restoring or reestablishing corner:

1-5	1-6	1-7	2
ACCEPTED FD 1" ROUND IRON FOR SE COR SEC 10. COR IS RLS MCCLUNG 1974 COR OF RECORD (FD BOTH MM BTS, FIT OK). DEPT. SURVEYOR, KEN OSTLING, HERE IN 1975.	ACCEPTED FD 3/4" IRON ROD FOR E1/4 SEC 15. COR IS RLS M.MCCLUNG 1974 COR OF RECORD (FD BOTH M.M. WITS.,FIT OK). DEPT. SURVEYOR, KEN OSTLING, HERE IN 1975. CTR. N-S DIRT RD IS DUE E. 3'. FD 1 1/4" ROUND IRON IS S06°45'E, 14.22'.	FD PIPE FOR SE COR SEC 15. COR IS RLS, M.MCCLUNG, 1974 COR OF RECORD (FD BOTH MM WITS, FIT OK). COR IS IN APPROX. CTR E-W GRV. RD, IN LINE WITH DIRT RD N AND TRAIL SLY. DEPT. SURVEYOR, KEN OSTLING, HERE IN 1975.	ESTABLISHED NW COR, E1/2, NE 1/4 OF SEC 22 PER STANDARD BLM INSTRUCTIONS. COR FALLS IN CTR E-W GRV. RD.

C. Description of monument for corner and accessories established to perpetuate locating the position of the corner:

1-5			1-6			1-7			2		
FD 1" ROUND IRON; ADDED CED POST W/LOC TAG.			FD 3/4" IRON ROD; ADDED RLS CAP.			FD 1/2" PIPE.			DROVE 5/8"x 34" REROD W/RLS CAP.		
5" MAPLE(CLP 3)	N20°W	8.2'	* 14" OAK	DUE E	39.18'	10" R.OAK	N20°E	67.91'	15" OAK	S25°E	105.1'
* 14" TW.R.OAK	S70°E	13.8'	* 14" OAK	S50°E	53.15'	7" R.PINE	S45°E	39.45'	18" OAK	S25°W	135.9'
* 18" W.OAK	S80°W	18.3'	5" OAK	S85°W	44.87'	10" R.OAK	S30°E	56.77'	21" OAK	N25°E	145.4'
CTR RD,E-W-S	DUE S	30'±3'	7" OAK	N45°W	48.59'	6" R.PINE	S50°W	48.96'	CTR TRAIL SLY	DUE E	64'±2'
FD 1"x 1" SQ. IRON			SET CED POST W/LOC			SET CED POST W/LOC			CTR TRAIL NLY	DUE W	32'±2'
BURIED	S06°38'E	27.82'	TAG.	DUE W	33'	TAG.	N45°W	50'	SET CED POST W/LOC		
									TAG	DUE S	33'
* = RLS M.MCCLUNG WIT.			* = RLS M.MCCLUNG WIT.								

Signed by Carl F. Roser 3-30-89 Date _____

Surveyor's Michigan License No. 12028

STATE OF MICHIGAN
CARL F. ROSER
LAND SURVEYOR
No. 12028
REGISTERED LAND SURVEYOR

FORM APPROVED BY MICHIGAN STATE BOARD OF LAND SURVEYORS, JAN. 28, 1971
REVISED MAY 14, 1975
REVISED JAN., 1983