LAND CORNER RECORDATION CERTIFICATE

Filing Requirement of Act 74, Mich. P.A. 1970

For corners in CLARE (County)

	Located In:	Corner Code #/#
1. Public Land Survey	T 20N R 6W	M-9, M-10
	T ___ R ___	
	T ___ R ___	
	T ___ R ___	
2. Property Controlling	S 25 T ___ R ___	7, 14
in Section	S ___ T ___ R ___	
3. Miscellaneous	S ___ T ___ R ___	
Property in Sec.	S ___ T ___ R ___	

Register of Deeds Stamp & File Number

4. Lot No. _____ , Recorded Plat _____

5. Private Claims _____

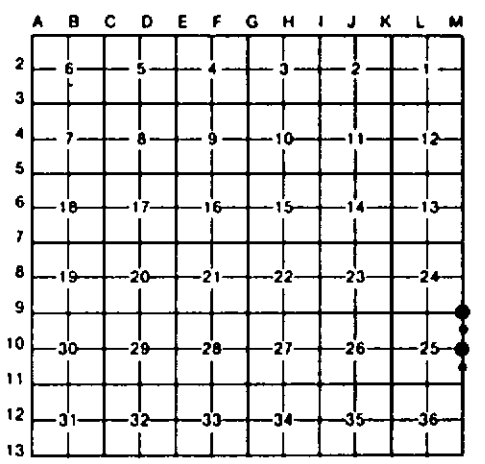

I, CARL F. ROSER, in a field survey on AUGUST 19, 19 91, do hereby certify that under requirements of P.A. 74, Michigan P.A. of 1970, the corner points mentioned in lines 1 and 2 above were in conformance with regulations and rules therefore as required in the current manual of survey instructions of the United States Department of the Interior, Bureau of Land Management or by a decree of a Court of Law and/or that the corner points mentioned in lines 3, 4 and 5 above were in conformance with the rules of the Michigan Board of Land Surveyors or by a Decree of a Court of Law; established, re-established, monumented, re-monumented, recovered, found as expressed below:

NOTE: Not more than 4 corners, all in the same town and range, may be recorded on this certificate.

A. Description of original monument and accessories and/or subsequent restoration:

M-9 M-10 7 14

B. Description of corner evidence found and/or method applied in restoring or reestablishing corner:

M-9	M-10	7	14
ACCEPTED FD 1/2" REROD W/RLS CAP #13030 FOR NE COR SEC 25. S'LY EDGE OF BAYOU IS 61'±N. FITS 1977 & 1980 SURVEYS OF SEC'S 24 & 25 BY GOURDIE-FRASER & ASSOC.	FD 1" PIPE FOR E 1/4 COR SEC 25. GOURDIE-FRASER & ASSOC. SET THIS MON WHEN SUBDIVIDING SEC 25 IN 1980. CTR N-S TRAIL IS 2'E. ALSO FITS OLDER W.S. MOORE SURVEY OF SE 1/4 OF SEC 25.	FD 1" PIPE FOR SE COR OF N 1/2 OF NE 1/4 OF SEC 25. GOURDIE-FRASER & ASSOC. SET THIS MON HALFWAY & ON LINE BETWEEN NE SEC COR & E 1/4 COR OF SEC 25 IN 1980. CTR TRAIL IS 158'± 5'E.	ACCEPTED FD 4" DIA CONC MON WITH 1/2" REROD FOR SE COR OF NE 1/4 OF SE 1/4 OF SEC 25. GOURDIE-FRASER & ASSOC. FD & USED THIS MON IN THEIR SUBDIVISION OF SEC 25 IN 1980. CTR N-S TRAIL IS 19'W. FD CONC MON ALSO FITS OLD PRIOR SURVEY OF SE 1/4 OF SEC 25 BY W.S. MOORE. (SEE COR REC M-11).

C. Description of monument for corner and accessories established to perpetuate locating the position of the corner:

M-9	M-10	7	14
FD 1/2" REROD W/RLS CAP; ADDED DNR MON & SET CED POST.	FD 1" PIPE.	FD 1" PIPE; ADDED CED POST W/LOC TAG.	FD CONC MON; ADDED CED POST W/LOC TAG.
* 6" W PINE N75°W 9.25'	6" W PINE N55°W 26.83'	*30" W PINE N70°W 40.95'	6" R PINE N15°E 15.4'
*27' W PINE N20°W 50.58'	* 6" R PINE N35°E 27.27'	4" W PINE N60°E 15.3'	9" R PINE S85°E 20.5'
*27" W PINE N15°E 73.59'	* 8" R PINE S35°E 29.10'	7" R PINE S45°E 19.7'	6" R PINE S20°W 13.8'
4" W PINE S65°E 3.79'	*12" B OAK S60°W 35.62'	*15" B OAK SOUTH 40.10	FD 3/4" IR ROD WEST 15.45'
	SET CED POST W/LOC TAG BESIDE FD 1/2" REROD WEST 33'		FD 3/4" IR ROD WEST 33'
*GOURDIE-FRASER & ASSOC. WIT.	*GOURDIE-FRASER & ASSOC. WIT.	*GOURDIE-FRASER & ASSOC WIT..	

Signed by Carl F. Roser 12028 8-10-92 Date _____

Surveyor's Michigan License No. _____

STATE OF MICHIGAN CARL F. ROSER LAND SURVEYOR 12028 REGISTERED LAND SURVEYOR

FORM APPROVED BY MICHIGAN STATE BOARD OF LAND SURVEYORS, JAN. 28, 1971 REVISED MAY 14, 1975 REVISED JAN., 1983