LAND CORNER RECORDATION CERTIFICATE

Filing Requirement of Act 74, Mich. P.A. 1970

For corners in CLARE (County)

	Located In:	Corner Code #/#
1. Public Land Survey	T 20N R 6W	K-2, L-2
	T ___ R ___	
	T ___ R ___	
	T ___ R ___	
2. Property Controlling	S 1 T ___ R ___	3, 8
in Section	S ___ T ___ R ___	
3. Miscellaneous	S ___ T ___ R ___	
Property in Sec.	S ___ T ___ R ___	

Register of Deeds Stamp & File Number

4. Lot No. _____ , Recorded Plat _____
5. Private Claims _____

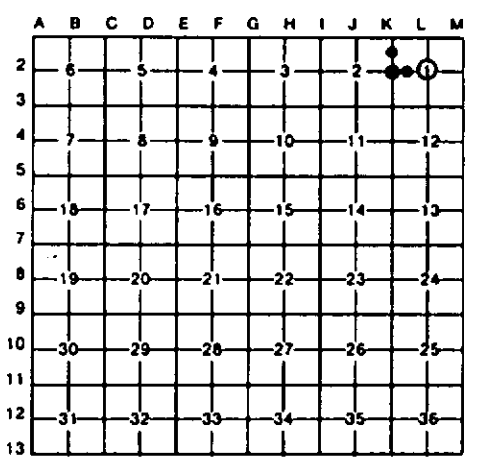

I, CARL F. ROSER, in a field survey on DECEMBER 3, 19 91, do hereby certify that under requirements of P.A. 74, Michigan P.A. of 1970, the corner points mentioned in lines 1 and 2 above were in conformance with regulations and rules therefore as required in the current manual of survey instructions of the United States Department of the Interior, Bureau of Land Management or by a decree of a Court of Law and/or that the corner points mentioned in lines 3, 4 and 5 above were in conformance with the rules of the Michigan Board of Land Surveyors or by a Decree of a Court of Law; established, re-established, monumented, re-monumented, recovered, found as expressed below:

NOTE: Not more than 4 corners, all in the same town and range, may be recorded on this certificate.

A. Description of original monument and accessories and/or subsequent restoration:

K-2 L-2 3 8

B. Description of corner evidence found and/or method applied in restoring or reestablishing corner:

K-2
ACCEPTED SUCKER ROD FOR N 1/4 COR SEC 1. CTR N-S DIRT RD IS 4' E. COR IS IN CTR DIRT RD TO N. COR FITS P. LAPHAM 1975 WITS OF RECORD & WAS USED BY K. OSTLING IN 1976 DEPT SURVEY & J. KNAPP IN 1988 CERT OF SURVEY.

L-2
ACCEPTED FD 1/2" REROD FOR CTR SEC 1. REROD FITS WITS OF 1975 RECORD BY L.S. P. LAPHAM.

3
FD & ACCEPTED L.S. J. KNAPP IRON FOR NW COR OF SW 1/4 OF FRL NW 1/4 OF SEC 1. (OR SW COR OF LOT 3, SEC 1 OF 1856 RESURVEY GLO PLAT. RUN-OUT SEC TO MICH 2ND CORR LINE.) J. KNAPP 1987 CERT OF SURVEY INDICATES HE FOUND IRON HERE.

8
ESTABLISHED SE COR OF SW 1/4 OF NW 1/4 OF SEC 1 PER STD BLM INSTRUCTIONS. CTR E-W TRAIL IS 19' ± N. CTR OF POWER LINE (NE-SW) IS S50°E, 50' (± 3').

C. Description of monument for corner and accessories established to perpetuate locating the position of the corner:

K-2
FD 1" THREADED, MALE END, SUCKER ROD.
#23" MAPLE(CLP5) N30°E 76.89
#18" W OAK S15°W 71.42
#20" MAPLE S75°W 76.59
SET CED POST W/ LOC TAG. EAST 33'

*RLS P. LAPHAM WIT.

L-2
FD 1/2" REROD; ADDED CED POST W/LOC TAG.
CTR 3" O.D. PIPE POST SW COR NW FN ENCLOSURE N70°W 31.8'
CTR 11" O.D. VERTICAL PIPE #502-20 N85°E 22.9'
#10" B OAK S50°E 78.54'
#12" B OAK S35°W 65.20'

*RLS PAUL LAPHAM WITS.

3
FD 5/8" X 18" REROD W/RLS CAP. SET CED POST W/LOC TAG.
10" TW MAPLE N50°W 6.1'
4" MAPLE N80°E 5.0'
6" MAPLE S50°E 13.3'
11" TRPL R OAK S05°E 14.9'
N 1/4 COR OF SEC 1 S00°00'50"E 1280.04

8
DROVE 5/8" X 34" REROD W/RLS CAP. SET CED POST W/LOC TAG.
2" W PINE N80°E 17.2'
4" MAPLE S05°E 17.9'
7" MAPLE S60°W 12.4'

Signed by Carl F. Roser 12-02-92 Date _____

Surveyor's Michigan License No. 12028

STATE OF MICHIGAN CARL F. ROSER LAND SURVEYOR No. 12028 REGISTERED LAND SURVEYOR

FORM APPROVED BY THE MICHIGAN STATE BOARD OF LAND SURVEYORS, JAN. 28, 1971
REVISED MAY 14, 1975
REVISED JAN., 1983