


LAND CORNER RECORDATION CERTIFICATE

Filing Requirement of Act 74, Mich. PA 1970

For Corners In:			
Clare	Located In	Corner Code #	
(County)			
1. Public Land Survey	T 20N R 6W	I-12	
	T	R	
2. Property Controlling in Section	S 34 T 20N R 6W	14	
	S T R		
3. Miscellaneous Property in Section	S T R		
	S T R		

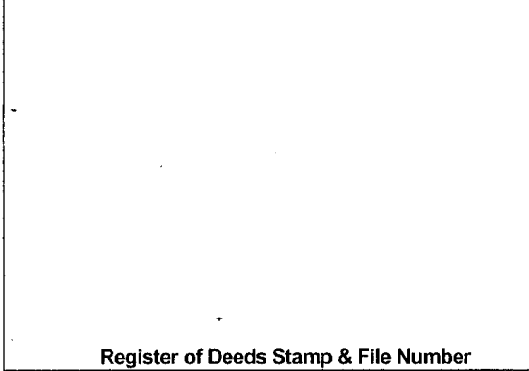

4. Lot No: _____ Recorded Plat: _____

5. Private Claims: _____

I, Craig W. McVean, in a field survey on Oct. 24, 2008 do hereby state that under requirements of PA 74, Michigan PA of 1970, the corner points mentioned in lines 1 and 2 above were in conformance with regulations and rules therefore as required in the current manual of survey instructions of the United States Department of the Interior, Bureau of Land Management or by a decree of a Court of Law and/or that the corner points mentioned in lines 3, 4 and 5 above were in conformance with the rules of the Michigan Board of Land Surveyors or by a Decree of a Court of Law; established, re-established, monumented, recovered, found as expressed below:


NOTE: Not more than 2 corners, all in the same town and range, may be recorded on this certificate.

	A	B	C	D	E	F	G	H	I	J	K	L	M
1													
2	6	5	4	3	2	1							
3													
4	7	8	9	10	11	12							
5													
6	18	17	16	15	14	13							
7													
8	19	20	21	22	23	24							
9													
10	30	29	28	27	26	25							
11													
12	31	32	33	34	35	36							
13													

A. Description of original monument and accessories and/or subsequent restoration:

- I-12 – 1856 – Set ¼ Post – F. Coleman
- 1) Elm 6" N47°W 41 L.; 2) W. Birch 16" S21°E 17 L.
- 1959 – Consumer Power Co. (CPC) Notes and Wit. Sheet – Fd. old wood stake and blazed trees. Set CPC Marker
- 3) 10" Cedar S20°±W 8.7' (Old Blaze)
- 4) 8" Poplar N. 2.5' (Old Blaze)
- 5) 12" Poplar S25°±E 19.0' (Blazed)
- 6) 9" Poplar West 25.2' (Blazed)
- 1972 – LCRC – L. 1, p. 171 & P. B. Lapham & CPC Witness Sheet – Found 2" pipe. S 80° inter roads
- 3) S10°W 9.20' – 15" Cedar; 7) S70°E 24.45' – 12" Cedar
- 1972 – Rec. Survey – L. 1, p. 278
- J. W. Sedgman – Same as Lapham LCRC
- 1985 – Rec. Survey – L. 2, p. 897 - P. B. Lapham – Fd. 2" pipe – CPC Mon. – Same Wit. As 1972 LCRC
- 1998 – Unrecorded Survey – Gourdie-Fraser & Assoc – Job # 980043 – Fd. C. P. Co. 2" pipe and cap
- 8) S11°W 9.17' – 12" Cedar; 7) S64°E 24.45' – 12" Cedar
- 9) N61°E 15.65' – 12" Maple; 10) N79°W 24.60' – 8" Maple

- 14 – 1998 – Unrecorded Survey – Gourdie-Fraser & Assoc – Job #980043 – iron set

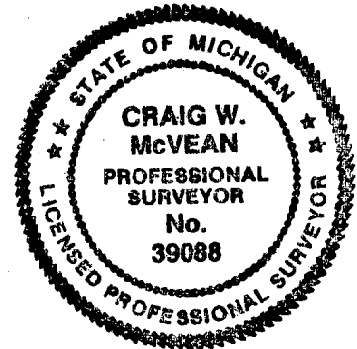

B. Description of corner evidence found and/or method applied in restoring or re-establishing corner:

- I-12 – ¼ Corner common to Sec. 34 & 35 – Fd. 3" CPC Cap on 2 ½" O.D. iron pipe – Up 2'. South 9' to Bottom of Bank. South 42'± (105.6' - GLO) to Top of Bank. North 75'± (46.9' - GLO) to S. Edge of 8'± wide stream course NW. Measured South 2590.36' (2603.7' - GLO) to 'I-13'. CPC Monument accepted as the best available evidence of the position of the original corner.

- 14 – S 1/16 Cor. common to Sec. 34 & 35 – Fd. ½" x 18" rebar w/ cap # 25875 & 21568. 5.5' W. of Centerline N-S Sand Rd. Centerline Sand Rd. to East is 35'± S. ½" CIR accepted as the best available evidence of the position of the corner.

C. Description of monument for corner and accessories established to perpetuate locating the position of the corner:

- I-12 – 3" CPC Cap on 2 ½" O.D. iron pipe – 2' up. Set Blue Carsonite Post 1' East
- S5°W 9.11' to fd. nail in W. side 14" Cedar (#8)
- S73°E 24.43' to fd. nail in N. side 17" Cedar (#7)
- N52°E 15.69' to fd. nail in SE side 13" R. Maple (#9)
- N85°W 24.56' to fd. nail in N. side 10" S. Maple (#10)
- S40°W 9.07' to set N & T in NW side 21" Cedar (#3)

- 14 – Replaced ½" x 18" CIR with stamped 2" Aluminum Cap on 5/8" x 34" rebar
- West 33.00' to Fd. ½" CIR #25875 & 21568 and add Blue Carsonite Post with loc. Tag
- S53°W 52.36' to Top center Well head #59-3
- S42°E 75.03' to set N & T in NE side 14" Oak
- N28°E 84.65' to set N & T in SW side 8" Oak

Signed by: Craig W. McVean
 Surveyor's Michigan License No.: 39088

Date: 5/26/2009