

FEB 13 1998

9
2

SECTION

Clinton County Remonumentation
Northeast Corner Section 6 and Northwest Corner Section 5,
T. 5N.-R. 1W., Bath Township

LAND CORNER RECORDATION CERTIFICATE
Filling Requirement of Act 74, Mich. P.A. 1970

LIBER 004 PAGE 274

For corners in

<u>Clinton</u>	Located In:	Corner Code #
(County)		
1. Public Land Survey	T <u>5N</u> R <u>1W</u> C- <u>1</u>	
	T _____ R _____	
	T _____ R _____	
	T _____ R _____	
2. Property Controlling in Section	S _____ T _____ R _____	
	S _____ T _____ R _____	
3. Miscellaneous Property in Sec.	S _____ T _____ R _____	
	S _____ T _____ R _____	
4. Lot No. _____, Recorded Plat _____		
5. Private Claims _____		

RECORDED

DEC 28 3 33 PM '98

REGISTER OF DEEDS
CLINTON COUNTY, MICH.
Arvid Woodley

Register of Deeds Stamp & File Number

I, Samuel J. Clark, in a field survey on July 23, 1998 do hereby state that under requirements of P.A. 74, Michigan P.A. of 1970, the corner points mentioned in lines 1 and 2 above were in conformance with regulations and rules therefore as required in the current manual of survey instructions of the United States Department of the Interior, Bureau of Land Management or by a decree of a Court of Law and for that the corner points mentioned in lines 3, 4 and 5 above were in conformance with the rules of the Michigan Board of Land Surveyors or by a Decree of a Court of Law; established, re-established, monumented, recovered, found as expressed below:

NOTE: Not more than 2 corners, all in the same town and range, may be recorded on this certificate.

1	B	C	D	E	F	G	H	I	J	K	L	M
2	6	5	4	3	2	1						
3												
4	7	8	9	10	11	12						
5												
6	18	17	16	15	14	13						
7												
8	19	20	21	22	23	24						
9												
10	30	29	28	27	26	25						
11												
12	31	32	33	34	35	36						
13												

A. Description of original monument and accessories and/or subsequent restoration:


C-1 Northeast corner of Section 6 and Northwest corner of Section 5, Bath Twp.
Originally surveyed by Deputy Surveyor Hervey Parke Nov. 11-Nov. 20, 1826
Survey of Section 6 by R.H. Colburn, December 10, 1883 and following days, "found stone", no witnesses provided (Over)

B. Description of corner evidence found and/or method applied in restoring or reestablishing corner:

C-1 Northeast corner of Section 6 and Northwest corner of Section 5, Bath Twp.
Found 3/4" square iron bar 12' south of gravel drive
Found "PK" nail East side of P.Pole N37°W, 80.72'
Found 16" Ash S41°E, 45.0'
Found 24" Oak, N88°W, 29.6'
and is accepted as the best available evidence of the position of the original corner.

C. Description of monument for corner and accessories established to perpetuate locating the position of the corner:

C-1 Northeast corner of Section 6 and Northwest corner of Section 5, Bath Twp.
*Set Standard Clinton County Monument
Found "PK" nail East side of P.Pole N37°W, 80.72'
Set Nail and Tag #41096 North face 16" Ash S41°E, 45.0'
Set Nail and Tag #41096 Northeast Face 24" Oak, N88°W, 29.6'
Set Nail and Tag #41096 North Face 36" Oak, S75°E, 122.53'
*Standard Clinton County Monument at C-13, Bath Township, S.89°59'37"E. 180.97'
*Standard Clinton County Monument at B-13, Bath Township, N.89°59'37"W. 2454.04'
*Standard Clinton County Monument being a 2 1/2" Diameter Steel Tube, 30" long, with a stamped brass cap, restamped #41096, and breakaway magnetic base.

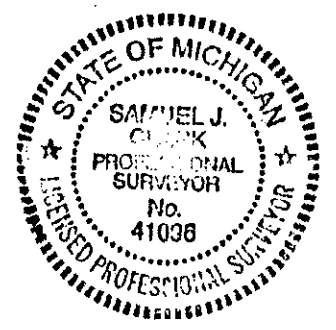

Signed by Samuel J. Clark
Surveyor's Michigan License No. 41096

Date 12/22/98

APPROVED BY
CLINTON COUNTY PEER GROUP
DATED 11/17/98
278

SURVEY &
RECORDS DEPARTMENT

FEB 28 1999

SECTION

- ◆ Certificate of Survey, G. Fauser, # 16089, January, 1973,
Fd. 3/4" square iron bolt
P. Pole S20°W 140.6'
P. Pole N45°W 80.76'
C.L. Drive North 12.3'
- ◆ L.C.R.C. *A. Pierce* # 13039, Nov. 19, 1976
Fd. 3/4" square iron bolt
18" Oak S85°W, 30.54'
P. Pole N37°W 80.72'
C.L. Drive North 12'
- ◆ Certificate of Survey, L. Bryan, # 25832, L. 4, Pg. 130, March 5, 1984
Fd. 3/4" square iron 12" South of gravel drive
Set Nail & Tag in 18" Oak S85°W, 30.54'
Fd. "PK" nail East side P. Pole, N37°W 80.72'
Set nail & Tag Northeast side 5" Ash N40°E 45.64'