

**Clinton County, Michigan Monumentation.**  
**North 1/4 Corner Section 5, T. 5N.-R. 1W., Bath Township**  
**LAND CORNER RECORDATION CERTIFICATE**  
**Filing Requirement of Act 74, Mich. P.A. 1970**

LIBER 004 PAGE 276

RECORDED

Dec 28 3 33 PM '98

REGISTER OF DEEDS  
 CLINTON COUNTY, MICH.

*Carol Winkley*

Register of Deeds Stamp & File Number

For corners in SECTION \_\_\_\_\_

Clinton _____	Located In:	Corner Code #	
(County)			
1. Public Land Survey	T <u>5N</u>	R <u>1W</u>	D- <u>1</u>
	T _____	R _____	_____
	T _____	R _____	_____
	T _____	R _____	_____
2. Property Controlling in Section	S _____	T _____	R _____
	S _____	T _____	R _____
3. Miscellaneous Property in Sec.	S _____	T _____	R _____
	S _____	T _____	R _____

4. Lot No. \_\_\_\_\_, Recorded Plat \_\_\_\_\_  
 5. Private Claims \_\_\_\_\_

I, Samuel J. Clark, in a field survey on July 23, 1998 do hereby state that under requirements of P.A. 74, Michigan P.A. of 1970, the corner points mentioned in lines 1 and 2 above were in conformance with regulations and rules therefore as required in the current manual of survey instructions of the United States Department of the Interior, Bureau of Land Management or by a decree of a Court of Law and /or that the corner points mentioned in lines 3, 4 and 5 above were in conformance with the rules of the Michigan Board of Land Surveyors or by a Decree of a Court of Law; established, re-established, monumented, recovered, found as expressed below:

**NOTE: Not more than 2 corners, all in the same town and range, may be recorded on this certificate.**

	B	C	D	E	F	G	H	I	J	K	L	M
1												
2	6		5		4		3		2		1	
3												
4	7		8		9		10		11		12	
5												
6	13		17		15		15		14		13	
7												
8	19		20		21		22		23		24	
9												
10	30		29		28		27		26		25	
11												
12	31		32		33		34		35		36	
13												

A. Description of original monument and accessories and/or subsequent restoration:


D-1 North 1/4 Corner Section 5, Bath Twp.  
 Corner not set in original survey of Section 5  
 Division of section by petition in 1902 by Charles Eddy, County Surveyor,  
 Stone found with no witnesses recorded, recorded distance to C-1, Bath and E-1, Bath corner 2658.48'  
 (Over)

B. Description of corner evidence found and/or method applied in restoring or reestablishing corner:

D-1 North 1/4 Corner Section 5, Bath Twp.  
 Found steel fence post per L. 1, Pg. 263, with the follow witnesses:  
 N&T #25832 5"Maple N60°W, 26.15'  
 N&T #25832 9" Willow North 21.60'  
 N&T #25832 5"Maple N21°E, 19.25'  
 and is accepted as the best available evidence of the position of the original corner

C. Description of monument for corner and accessories established to perpetuate locating the position of the corner:

D-1 North 1/4 Corner Section 5, Bath Twp.  
 \*Set Standard Clinton County Monument  
 N&T #25832 5"Maple N60°W, 26.15'  
 N&T #25832 9" Willow North 21.60'  
 N&T #25832 5"Maple N21°E, 19.25'  
 \*Standard Clinton County Monument at C-13, Bath Township, N.89°58'42"W. 2472.11'  
 \*Standard Clinton County Monument at D-13, Victor Township, S.89°58'42"E. 182.05'  
 \*Standard Clinton County Monument being a 2 1/2" Diameter Steel Tube, 30" long, with a stamped brass cap, restamped #41096, and breakaway magnetic base.

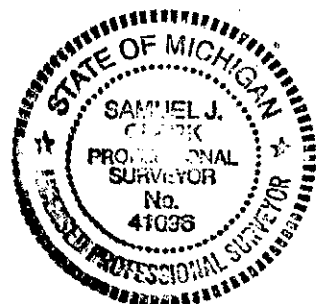

Signed by *Samuel J. Clark*  
 Surveyor's Michigan License No. 41096

Date 12/23/98

APPROVED BY  
 CLINTON COUNTY PEER GROUP  
 DATED 11/17/98  
*J. J. J.*

- ◆ Certificate of Survey, G. Fauser, # 16089, January, 1973,  
Fd. Metal fence post set in marsh at old wood fence corner post  
3" Maple N60°W, 29.30'  
9" Willow North 21.73'  
3" Maple N21°E, 18.35'  
Distance from D-1 to C-1, 2653.94' and distance D-1 to E-1, 2675.04'
  
- ◆ Certificate of Survey, A. Pierson, # 13039, January, 1973, L. 1, Pg. 263.  
Fd. Metal fence post set in marsh at old rotten wood fence corner post  
3" Maple N60°W, 27.30'  
9" Willow North 21.73'  
3" Maple N21°E, 18.35'  
Distance from D-1 to north 1/8 corner recorded as 1335.61'
  
- ◆ Certificate of Survey, H. Eustrom, Civil Engineer # 3015, July, 1975,  
No description of monumentation found
  
- ◆ Certificate of Survey, A. Pierson, # 13039, January, 1981, L. 2, Pg. 383  
No description of monumentation found  
Distance from D-1 to C-1 recorded as 2653.32'
  
- ◆ Certificate of Survey, L. Bryan, July, 1983, L. 4, Pg. 139  
Fd. fence post 1.5' S. of fence and 190° +/- West of the centerline of Babcock road from notes obtained from Arden Pierson  
Set N&T North side 5" Maple N60°W, 26.15'  
Set N&T East side 9" Willow North 21.60'  
Set N&T West side 5" Maple N21°E, 19.25'  
Recorded distance of 2653.27' to C-1, Bath
  
- ◆ Certificate of Survey, M. VanRaemdonck, # 24622, March, 1991, L. 4, Pg. 275  
Fd. fence post 190', more or less, West of the centerline of Babcock road  
Set N&T 5" Maple N60°W, 26.15'  
Set N&T 9" Willow North 21.60'  
Set N&T 5" Maple N21°E, 19.25'  
N89°40'43"E 182.04' South 1/4 corner Section 32, T6N-R1W
  
- ◆ Certificate of Survey, M. VanRaemdonck, # 24622, March, 1991, L. 4, Pg. 320 (rev. of L. 4, Pg. 275)  
Fd. fence post 190', more or less, West of the centerline of Babcock road  
Set N&T 5" Maple N60°W, 26.15'  
Set N&T 9" Willow North 21.60'  
Set N&T 5" Maple N21°E, 19.25'  
N89°40'43"E 182.04' South 1/4 corner Section 32, T6N-R1W

SURVEY &  
MONUMENTATION

FEB 18 1999

SECTION