

SECTION

Clinton County Remonumentation
Northwest Corner Section 4 and the Northeast Corner of Section 5,
T. 5N.-R. 1W., Bath Township

LAND CORNER RECORDATION CERTIFICATE LIBER 004 PAGE 2-7-8
Filing Requirement of Act 74, Mich. P.A. 1970

For corners in

<u>Clinton</u>	Located In:	Corner Code #
(County)		
1. Public Land Survey	T <u>5N</u> R <u>1W</u> E- <u>1</u>	
	T _____ R _____	
	T _____ R _____	
	T _____ R _____	
2. Property Controlling in Section	S _____ T _____ R _____	
	S _____ T _____ R _____	
3. Miscellaneous Property in Sec.	S _____ T _____ R _____	
	S _____ T _____ R _____	

RECORDED
Dec 28 3 33 PM '98
REGISTER OF DEEDS
CLINTON COUNTY, MICH.
Charles Eddy
Register of Deeds Stamp & File Number

4. Lot No. _____, Recorded Plat _____
5. Private Claims _____

I, Samuel J. Clark, in a field survey on July 23, 1998, do hereby state that under requirements of P.A. 74, Michigan P.A. of 1970, the corner points mentioned in lines 1 and 2 above were in conformance with regulations and rules therefore as required in the current manual of survey instructions of the United States Department of the Interior, Bureau of Land Management or by a decree of a Court of Law and for that the corner points mentioned in lines 3, 4 and 5 above were in conformance with the rules of the Michigan Board of Land Surveyors or by a Decree of a Court of Law; established, re-established, monumented, recovered, found as expressed below:

NOTE: Not more than 2 corners, all in the same town and range, may be recorded on this certificate.

1	B	C	D	E	F	G	H	I	J	K	L	M
2	6	5	4	3	2	1						
3												
4	7	8	9	10	11	12						
5												
6	18	17	16	15	14	13						
7												
8	19	20	21	22	23	24						
9												
10	30	29	28	27	26	25						
11												
12	31	32	33	34	35	36						
13												

A. Description of original monument and accessories and/or subsequent restoration:

E-1 Northwest corner of Section 4 and the Northeast corner of Section 5, Bath Twp.

Original survey of line between section 4 and 5 by Deputy Surveyor Hervey Parke, November, 1826 corner not set (falls in lake), no accessories given.

Division of Section by petition in 1902 by Charles Eddy - County Surveyor, corner in lake 2 chs. Sth. on bank set stake. witness (a) 14" Elm S.61°W. 2.50 chs. 1.50 chs. W. on bank set stake. Witness (a) 14" Elm N.89°W. 2.37 chs.

(Over)

B. Description of corner evidence found and/or method applied in restoring or reestablishing corner:

E-1 Northwest corner of Section 4 and the Northeast corner of Section 5, Bath Twp.

No evidence of corner was found, corner established at original closing distance of 143.88' from E-13, Victor Twp.

C. Description of monument for corner and accessories established to perpetuate locating the position of the corner:


E-1 Northwest corner of Section 4 and the Northeast corner of Section 5, Bath Twp.

*Set Standard Clinton County Monument at reference corner lying S.89°-45'-06"W., 380.00' from the actual corner. Accessories to said reference being:

- N&T #41096 20" Oak N78°W, 19.21'
- N&T #41096 20" Oak S64°W, 33.49'
- N&T #41096 14" Maple Clump S22°W, 36.65"
- N&T #41096 20" Oak S62°E, 36.65'

*Standard Clinton County Monument at D-13, Bath Twp. S.89°-45'-06"W. 2496.78'
E-13, Victor Twp. (calc'd position) N.89°-45'-06"E. 143.88'

*Standard Clinton County Monument being a 2 1/2" Diameter Steel Tube, 30" long, with a stamped brass cap, restamped #41096, E-1 Ref and breakaway magnetic base.

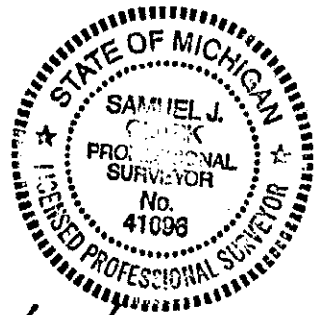

Signed by Samuel J. Clark Date 12/23/98
Surveyor's Michigan License No. 41096

APPROVED BY
CLINTON COUNTY PEER GROUP
DATED 11/17/98
J. J. J.

- ◆ Rec'd Survey by A. Pierson, #13039, January 20, 1973, L. 1, Pg. 263, no description of corner, no witnesses provided, however, a distance measured from D-1 to the north 1/8th corner was 1335.61', which, when doubled, would give a distance of 2671.22'
- ◆ Rec'd survey by G. Fauser, #18657, L. 2, Pg. 154, March 21, 1977, no description of corner, no witnesses provided, however, a distance measured from F-1 to E-1 is shown as 2675.04'
- ◆ Rec'd Survey by D. Richardson, #31603, June 29, 1987, L. 3, Pg. 103 no description of corner, no witnesses provided, however, a distance measured from F-1 to E-1 is shown as 2675.04'

SURVEY & MEASUREMENT

FEB 18 1939

SECTION