

9-2

Clinton County Remonumentation
North 1/4 Corner Section 4, T. 5N.-R. 1W., Bath Township
LAND CORNER RECORDATION CERTIFICATE
Filing Requirement of Act 74, Mich. P.A. 1970

004 PAGE 280

RECORDED

DEC 28 3 33 PM '98

REGISTER OF DEEDS
 CLINTON COUNTY, MICH.

Rand Winkey

Register of Deeds Stamp & File Number

For corners in

<u>Clinton</u>	Located In:	Corner Code #
(County)		
1. Public Land Survey	T <u>5N</u> R <u>1W</u> F-1	
	T _____ R _____	
	T _____ R _____	
	T _____ R _____	
2. Property Controlling in Section	S _____ T _____ R _____	
	S _____ T _____ R _____	
3. Miscellaneous Property in Sec.	S _____ T _____ R _____	
	S _____ T _____ R _____	

4. Lot No. _____, Recorded Plat _____
 5. Private Claims _____

I, Samuel J. Clark, in a field survey on July 23, 1998 do hereby state that under requirements of P.A. 74, Michigan P.A. of 1970, the corner points mentioned in lines 1 and 2 above were in conformance with regulations and rules therefore as required in the current manual of survey instructions of the United States Department of the Interior, Bureau of Land Management or by a decree of a Court of Law and/or that the corner points mentioned in lines 3, 4 and 5 above were in conformance with the rules of the Michigan Board of Land Surveyors or by a Decree of a Court of Law; established, re-established, monumented, recovered, found as expressed below.

NOTE: Not more than 2 corners, all in the same town and range, may be recorded on this certificate.

	B	C	D	E	F	G	H	I	J	K	L	M
1												
2	6		5		4		3		2		1	
3												
4	7		8		9		10		11		12	
5												
6	18		17		16		15		14		13	
7												
8	19		20		21		22		23		24	
9												
10	30		29		28		27		26		25	
11												
12	31		32		33		34		35		36	
13												

A. Description of original monument and accessories and/or subsequent restoration:

F-1 North 1/4 Corner Section 4, Bath Twp.

Corner not set in original survey of Section 4

Rec'd survey by J. A. Porter, #19003, September 26, 1974, L. 1, Pg. 565 of surveys
 No description of monumentation found or set nor any witnesses reported

(Over)

B. Description of corner evidence found and/or method applied in restoring or reestablishing corner:

F-1 North 1/4 Corner Section 4, Bath Twp.

Established corner F-1 equidistant between E-1, Bath and G-1, Bath on Township Line and is accepted as a careful and faithful reestablishment of the position of the corner.

C. Description of monument for corner and accessories established to perpetuate locating the position of the corner:

F-1 North 1/4 Corner Section 4, Bath Twp.


*Set Standard Clinton County Monument

- Nail + Tag in Top of fence post N.12°E. 39.71'
- Nail + Tag in Top of Cor. fence post N.71°E. 126.55'
- Set Nail + Tag in West face 16" Maple N33°E. 129.32'
- 1/2" Rerod (no cap) N.89°-45'-06"E., 8.46'

*Standard Clinton County Monument at F-13, Victor Township, N.89°-45'-06"E. 120.30'

E-13; Bath Township (falls in lake) S.89°-45'-06"W. 2520.36'

*Standard Clinton County Monument being a 2 1/2" Diameter Steel Tube, 30" long, with a stamped brass cap, restamped #41096, and breakaway magnetic base.

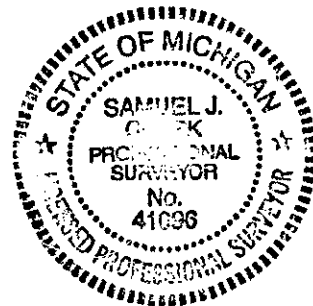

Signed by *Samuel J. Clark*
 Surveyor's Michigan License No. 41096

Date 12/23/98

APPROVED BY
 CLINTON COUNTY PEER GROUP
 DATED 11/17/98
J. J. J.

◆ L.C.R.C. by J. A. Porter, #19003, December 12, 1974
 Set 1/2" rerod and cap by proportionate measure S.89°24'10"W., 2657.08 from NE corner
 Nail + Tag in 12" Wild Cherry South 124.54'
 Nail + Tag in Top of fence post North 38.76'
 Nail + Tag in Top of Cor. fence post E.N.E. 118.55'
 Nail + Tag in 8" Maple NE 125.00'

◆ Rec'd survey by G. Fauser, #18657, L. 2, Pg. 154, March 21, 1977
 Set 1/2"x 24" rebar from Porter's witnesses
 12" Wild Cherry South 124.54'
 Top of fence post N.12°W. 38.76'
 Top of fence post N.70E. 118.55'
 8" Maple N.30°E. 125.00'

◆ Rec'd survey by D. Richardson, #31603, L. 2, Pg. 154, March 21, 1977
 Fd. 1/2"x 24" rebar
 12" Wild Cherry South 124.54'
 Top of fence post N.12°W. 38.76'
 Top of fence post N.70E. 118.55'
 8" Maple N.30°E. 125.00'

SURVEY & RECORDED INSTRUMENTATION

FEB 20 1999

SECTION