

**SURVEY &
REMONUMENTATION**

**Remonumentation
Bath Township**

MAY 17 1995

**LAND CORNER RECORDATION CERTIFICATE
Filing Requirement of Act 74, Mich. P.A. 1970**

For commission

RECORDED
LIBER 4, PAGE 68

MAY 22 2 00 PM '95

REGISTER OF DEEDS
CLINTON COUNTY, MICH.

Carol Wisby

Register of Deeds Stamp & File Number

Clinton (County) Located In: Corner Code #

1. Public Land Survey	T <u>5N</u> R <u>1W</u>	<u>G-5</u>
	T _____ R _____	_____
	T _____ R _____	_____
	T _____ R _____	_____
2. Property Controlling in Section	S _____ T _____ R _____	_____
	S _____ T _____ R _____	_____
3. Miscellaneous Property in Sec.	S _____ T _____ R _____	_____
	S _____ T _____ R _____	_____

4. Lot No. _____, Recorded Plat _____
5. Private Claims _____

A	B	C	D	E	F	G	H	I	J	K	L
2	6	5	4	3	2	1					
3											
4	7	8	9	10	11	12					
5											
6	16	17	18	15	14	13					
7											
8	19	20	21	22	23	24					
9											
10	30	29	28	27	26	25					
11											
12	31	32	33	34	35	36					

I, Dwight R. Schofield, in a field survey on January 27, 1994, do hereby certify that under requirements of P.A. 74, Michigan P.A. of 1970, the corner points mentioned in lines 1 and 2 above were in conformance with regulations and rules therefore as required in the current manual of survey instructions of the United States Department of the Interior, Bureau of Land Management or by a decree of a Court of Law and/or that the corner points mentioned in lines 3, 4 and 5 above were in conformance with the rules of the Michigan Board of Land Surveyors or by a Decree of a Court of Law; established, re-established, monumented, re-monumented, recovered, found as expressed below:

NOTE: Not more than 4 corners, all in the same town and range, may be recorded on this certificate.

A. Description of original monument and accessories and/or subsequent restoration:
Original survey by Harvey Parke in November of 1826

Post				
Tamarack	121	S 70° W	17	
Tamarack	12	N 58 1/2° E	37	

(SEE BACK OF SHEET)

B. Description of corner evidence found and/or method applied in restoring or reestablishing corner:

Found 1/2" Rebar in centerline of old unused road bed			
North	nail & tag in West side of 48" Oak	170.22'	
N 75° W	nail & tag #34976 in 40" Oak	44.02'	

and is accepted as a careful and faithful perpetuation of the position of the original corner. Removed 1/2" Rebar 36" long and set standard Clinton County monument. Verified position from Land Corner Recordation Certificate.


C. Description of monument for corner and accessories established to perpetuate locating the position of the corner:

Clinton County Monument

South	nail & tag #34976 in Power Pole	37.23'
S 10° W	nail & tag #34976 in 48" Oak	76.38'
North	nail & tag in West side of 48" Oak	170.22'
N 75° W	nail & tag #34976 in 40" Oak	44.02'

APPROVED BY
CLINTON COUNTY PEER GROUP
DATED 4/26/95
J. J. J.

Signed by *Dwight R. Schofield* Date October 24, 1994
Surveyor's Michigan License No. 34976

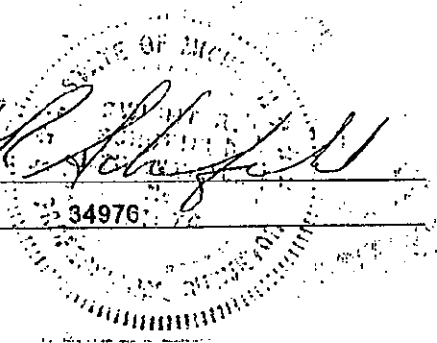

county surveyor Hollister records (no date)

No description given

Tamarack 6 N 85 3/4° E 38

Tamarack 6 N 86 1/4° W 41 1/2

Subsequent recordation of corner by James E. Stephens, PS 16053 and recorded in L.2, P.77 dated 7/16/76 and stated he found a 3/4" pipe on centerline of old unused road on a projection of an old fence to the North.

3/4" Pipe

Survey tag on the South side of a 40" Oak tree, N 78° 10' W, 44.24 feet

Survey tag on the West side of a 40" Oak tree, S 8° 11' W, 77.12 feet

Survey tag on the West side of a 40" Oak tree, N 0° 20' E, 168.92 feet