

**REMONUMENTATION  
BATH TOWNSHIP  
SECTION CORNER COMMON TO SECTION 2 AND 3  
LAND CORNER RECORDATION CERTIFICATE  
Filing Requirement of Act 74, Mich. P.A. 1970**

LIBER 004 PAGE 283

RECORDED

DEC 28 3 34 PM '98

REGISTER OF DEEDS  
CLINTON COUNTY, MICH.  
Register of Deeds Stamp  
& File Number

For corners in

Clinton  
(County)

Located in:

Corner Code #


- |                                       |                         |            |
|---------------------------------------|-------------------------|------------|
| 1. Public Land Survey                 | T <u>5N</u> R <u>1W</u> | <u>I-1</u> |
|                                       | T _____                 | _____      |
|                                       | T _____                 | _____      |
|                                       | T _____                 | _____      |
|                                       | T _____                 | _____      |
| 2. Property Controlling<br>In Section | S _____                 | _____      |
|                                       | S _____                 | _____      |
| 3. Miscellaneous<br>Property in Sec.  | S _____                 | _____      |
|                                       | S _____                 | _____      |
| 4. Lot No. _____                      | Recorded Plat _____     |            |
| 5. Private Claims _____               |                         |            |

I, Mark L. VanRaemdonck, in a field survey June 22, 1998 do hereby certify that under requirements of P.A. 74, Michigan P.A. of 1970, the corner points mentioned in lines 1 and 2 above were in conformance with regulations and rules therefore as required in the current manual of survey instructions of the United States Department of the Interior, Bureau of Land Management or by a decree of a Court of Law and/or that the corner points mentioned in lines 3, 4 and 5 above were in conformance with the rules of the Michigan Board of Land Surveyors or by a Decree of a Court of Law, established, re-established, monumented, re-monumented, recovered, found as expressed below:

**NOTE: Not more than 2 corners, all in the same town and range, may be recorded on this certificate.**

A. Description of original monument and accessories and/or subsequent restoration:

- Original, Hervey Parks, D.S., November 11-20, 1826, intersected Town Line 1.30 W  
Monument: Wood post  
Accessories: W Oak 25° S59°E 62  
Do 10° S54°W 45
- C.E. Hollister, His field book No. 2, page 38, May 14, 1890  
Monument: Not given.  
Accessories: W Oak 10° S23 1/2°E 48  
Y Oak 10° S59°E 72
- James Stephens, LCRC recorded in Liber 1, page 359, 5/15/72  
Monument: 3/4" Iron rod with square head. Set in centerline of Cutler Road on old fence line South  
Accessories: Survey tag in SE side 24" wild cherry N59°33'W 21.95'  
Survey tag in SW side 14" box elder N83°32'E 79.45'  
Survey tag in N side 48" oak S28°35'E 26.31'
- James Stephens, Certified Survey recorded in Liber 1, page 166, 9/14/72  
Monument and accessories are the same as No. 2.
- James Porter, Certified Survey, recorded in Liber 1, page 611, 6/9/75  
Monument and accessories not given.
- Glenn Fauser, Certified Survey, recorded in Liber 1, page 927, 8/25/77  
Monument: 3/4" iron rod with square head bolt  
Accessories: 24" Cherry N59°33'W 21.93 Stephens tag  
16" Red Oak N78°E 68.35' PK  
48" W. Oak S28°35'E 26.31
- Larry Bryan, Certified Survey, recorded in Liber 3, page 598, 3/7/90  
Monument: found 3/4" square bar  
Accessories: Found Stephens nail & tag N side 50" Oak S40°E 26.00'  
Set nail & tag S side 24" Cherry N50°W 22.00'  
Set nail & tag W side 40" Maple S 25.42'
- Larry Bryan, Certified Survey, recorded in Liber 4, page 125, 12/6/90  
Monument: Found square bar  
Accessories: Found nail & tag W side 20" Twin Maple S 25.42'  
Found Stephens nail & tag SE side 18" Wild Cherry N50°W 22.0  
Found Stephens nail & tag N side 48" Oak S40°E 26.15
- Larry Bryan, Certified Survey, recorded in Liber 4, page 133, 12/6/90  
Monument and accessories are the same as No. 8 above.
- Douglas Weir, Engineer 21094 Condominium Plan No. 12, recorded in Liber 741, page 460, 6/25/97  
No monument or accessories given.

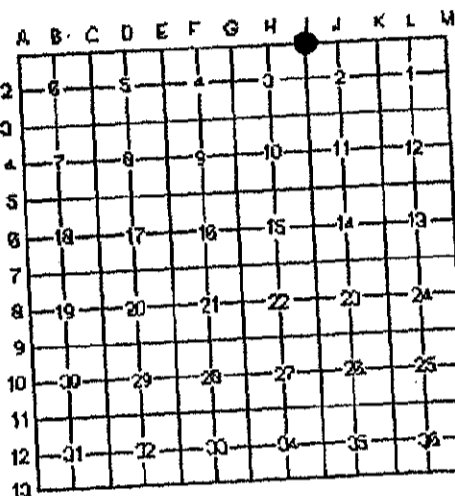

APPROVED BY  
CLINTON COUNTY PEER GROUP  
DATED 9/23/98



B. Description of corner evidence found and/or method applied in restoring or re-establishing corner:  
Found square bar as reference in No. 3, 6, 7 & 8 above. Found 48" Oak (that may be Hollister's witness from No. 2 above. Measured West 1.3 chains (GLO Jog 85.80 feet) from I-13, T6N-R1W. This location fit Hollister's bearing and distance to the center of the 48" Oak. At this location, I excavated a 4x4 area 1 1/2' deep. The excavation revealed no further evidence. The 48" Oak had no evidence of having been blazed. Since I could not find Hollister's monument or verify, without a doubt, that the 48" Oak was his witness, I accepted the 1" square bar as the best available evidence of the position of the original corner. A North and South ancient fence line when extended North hits this location. I established the true corner position on the line between corners I-13 and H-13 0.6' North of the 1" square bar.

C. Description of monument for corner and accessories to perpetuate locating the position of the corner:  
I installed a standard Clinton County Remonumentation Monument at the true corner position described in Section B above. The monument is a 2 1/2" diameter steel tube 30" long with a stamped brass cap. The corner position is witnessed by the following accessories:

- |              |  |
|--------------|--|
| S25°E 27.58' | Set nail & tag 24622 in W face of 48" Oak                      |
| South 26.22' | Set nail & tag 24622 in W face W trunk of twin 18" Sugar Maple |
| S65°W 48.38' | Set nail & tag 24622 in N face Yellow Birch                    |
| N05°E 31.11' | Set nail & tag 24622 in W face 18" Sassafras                   |

S89°42'04"W 2562.88' corner H-13, T6N-R1E  
N89°42'04"E 80.22' corner I-13, T6N-R1E

The bearings to corners H-13 and I-13 are based on a solar observation taken near the Southeast corner of Section 36, T6N-R1E.

Signed by Mark L. VanRaemdonck  
Surveyor's Michigan License No. 24622

Date NOV. 4, 1998

FORM APPROVED BY MICHIGAN STATE BOARD OF LAND SURVEYORS

JAN 18, 1971  
REVISED MAY 14, 1975  
REVISED JAN., 1983