

**SURVEY &
REMONUMENTATION**

APR 27 1995 **E 1/4 CORNER OF SECTION 13, BATH TWP.**

COMMISSION

**LAND CORNER RECORDATION CERTIFICATE
Filing Requirement of Act 74, Mich. P.A. 1970**

For corners in
Clinton
(County)

Located in: Corner Code #/1

RECORDED

- | | | |
|------------------------------------|-------------------------|------------|
| 1. Public Land Survey | T <u>5N</u> R <u>1W</u> | <u>M-6</u> |
| | T _____ R _____ | _____ |
| | T _____ R _____ | _____ |
| | T _____ R _____ | _____ |
| 2. Property Controlling in Section | S _____ T _____ R _____ | _____ |
| | S _____ T _____ R _____ | _____ |
| 3. Miscellaneous Property in Sec. | S _____ T _____ R _____ | _____ |
| | S _____ T _____ R _____ | _____ |
4. Lot No. _____, Recorded Plat _____
5. Private Claims _____

DEC 12 12 00 PM '94

REGISTER OF DEEDS
CLINTON COUNTY, MICH.

Arden S. Pierson
LIBER 4, PAGE 40

Register of Deeds Stamp & File Number

Arden S. Pierson DS in a field survey on March 14, 19 94, do hereby certify that under requirements of P.A. 74, Michigan P.A. of 1970, the corner points mentioned in lines 1 and 2 above were in conformance with regulations and rules therefore as required in the current manual of survey instructions of the United States Department of the Interior, Bureau of Land Management or by a decree of a Court of Law and/or that the corner points mentioned in lines 3, 4 and 5 above were in conformance with the rules of the Michigan Board of Land Surveyors or by a Decree of a Court of Law; established, re-established, monumented, re-monumented, recovered, found as expressed below:

	A	B	C	D	E	F	G	H	I	J	K
2	6		5		4		3		2		
3											
4	7		8		9		10		11		
5											
6	18		17		16		15		14		
7											
8	19		20		21		22		23		
9											
10	30		29		28		27		26		
11											
12	31		32		33		34		35		
13											

NOTE: Not more than 4 corners, all in the same town and range, may be recorded on this certificate.

A. Description of original monument and accessories and/or subsequent restoration:
M-6 - Original survey by Harvey Parke DS, 1826.

***(SEE BACK OF SHEET)**

B. Description of corner evidence found and/or method applied in restoring or reestablishing corner:

Section 13, Bath Township

M-6 - Found rerod & cap at base of old corner fence post in marsh. Verified location from Land Corner Recordation Certificates. And is accepted as a careful and faithful perpetuation of the position of the original corner. Removed rerod and many large stones and Set Standard Clinton County Monument with the top 3" above water, placed rerod next to monument below brass cap.


APPROVED BY
CLINTON COUNTY PEER GROUP
DATED 11/9/94
JFS

C. Description of monument for corner and accessories established to perpetuate locating the position of the corner:

M-6 (East 1/4 corner Section 13)
rerod & cap

Nail & tag #16053 S. side 12" Ash -N75°E- 18.72'
Steel "t" fence post -S20°W- 1.22'
Nail & tag #16053 W. side 8" Elm -N17°E- 12.77'
Nail & tag #25837 S. side 3" Tree -S66°W- 14.75'

*Standard Clinton County Monument is a 2 1/2" dia. steel tube 30" long with a stamped brass cap and breakaway magnetic base.

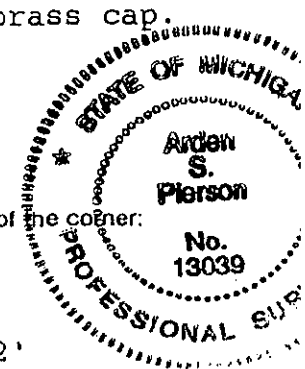

Signed by *Arden S. Pierson*

NOVEMBER 1, 1994

Surveyor's Michigan License No. 13039

(M-6)

Recorded in Liber 2, page 371, by James A. Porter PS #19008 dated October 28, 1980 -"Found stone and wood stake, left stone & stake in place & set 1/2" rerod & cap with Witnesses:

Nail & tag in 4" Elm -N45°E- 12.05'

Nail & tag in 8" Elm -S70°E- 18.69'

Nail & tag in corner fence post -S45°W- 0.66'

Nail & tag in 4" DBL Elm -West- 14.70' "

Recorded in Liber 2, page 806, by James E. Stephens PS #16053 dated November 25, 1991 -"Found rod & cap #25837 by base of old corner fence post with Witnesses:

Nail & tag in 4" DBL Elm -S45°W- 14.75'

Nail & tag in S. side 12" Poplar -N80°E- 18.70'

Nail & tag in W. side 8" Elm -N5°E- 12.73'

Nail & tag E. side fence corner post -S45°W- 0.45' "

LIBER 4, PAGE 41