

SURVEY & REMONUMENTATION

APR 27 1995 NE CORNER OF SECTION 24, BATH TWP.

COMMISSION

LAND CORNER RECORDATION CERTIFICATE
Filing Requirement of Act 74, Mich. P.A. 1970

For corners in
Clinton
(County)

Located In: Corner Code #

1. Public Land Survey	T <u>5N</u> R <u>1W</u>	<u>M-7</u>
	T _____ R _____	_____
	T _____ R _____	_____
	T _____ R _____	_____
2. Property Controlling in Section	S _____ T _____ R _____	_____
	S _____ T _____ R _____	_____
3. Miscellaneous Property in Sec.	S _____ T _____ R _____	_____
	S _____ T _____ R _____	_____

RECORDED

Dec 12 12 00 PM '94

REGISTERED DEEDS
 CLINTON COUNTY MICH.

Carol Wesley

LIBER 4, PAGE 43

Register of Deeds Stamp & File Number

4. Lot No. _____, Recorded Plat _____
 5. Private Claims _____

	A	B	C	D	E	F	G	H	I	J	K	L	M
2	6		5		4		3		2		1		
3													
4	7		8		9		10		11		12		
5													
6	18		17		16		15		14		13		
7													
8	19		20		21		22		23		24		
9													
10	30		29		28		27		26		25		
11													
12	31		32		33		34		35		36		
13													

Arden S. Pierson PS, in a field survey on March 14, 1994, do hereby certify that under requirements of P.A. 74, Michigan P.A. of 1970, the corner points mentioned in lines 1 and 2 above were in conformance with regulations and rules therefore as required in the current manual of survey instructions of the United States Department of the Interior, Bureau of Land Management or by a decree of a Court of Law and/or that the corner points mentioned in lines 3, 4 and 5 above were in conformance with the rules of the Michigan Board of Land Surveyors or by a Decree of a Court of Law; established, re-established, monumented, re-monumented, recovered, found as expressed below:

NOTE: Not more than 4 corners, all in the same town and range, may be recorded on this certificate.

A. Description of original monument and accessories and/or subsequent restoration:


M-7 - Original survey by Harvey Parke DS, 1826.
 Recorded in Liber 2, Page 371, by James A. Porter PS #19003, dated March 4, 1981. "GLO - Post: 20" Black Oak S70½°W 21 lks.
 21" White Oak N11°W 62 lks.
 1880 Co. Surveyor - Post & Stones: 4" Cherry S12°E 12 lks.
 6" B. Oak N58½°W 18½ lks.
 Found stone in roots of 30" Black Oak, set #4 rerod with cap."
 30" Black Oak West 27.25' 18" Black Oak S60°E 35.47'
 20" DBL. Maple East 34.42' 18" Cherry North 4.15'

B. Description of corner evidence found and/or method applied in restoring or reestablishing corner:

Section 24, Bath Township

M-7 - Found 1/2" iron with cap #25837 in roots of Black Oak.
 Accepted 1/2" iron as a careful and faithful perpetuation of the position of the original corner. Replaced 1/2" iron and cap With Standard Clinton County Monument - placed 1/2" iron next to monument below the top.

APPROVED BY
 CLINTON COUNTY PEER GROUP
 DATED 11/3/94
JFS

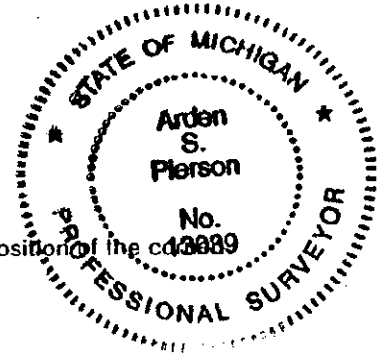

C. Description of monument for corner and accessories established to perpetuate locating the position of the corner:

M-7 (NE corner Section 24)
Clinton County Monument

Nail & tag #13039 W. side 16" Cherry -N10°E- 4.20'
 Nail & tag #13039 E. side 8" Oak -N36°W- 25.75'
 Nail & tag #13039 S. side 30" Oak -S85°W- 27.14'
 Nail & tag #13039 N. side 24" Maple -S89°E- 34.51'

*Standard Clinton County Monument is a 2½" steel tube 30" long with a stamped brass cap and breakaway magnetic base.

Signed by *Arden S. Pierson*

Date November 1, 1994

Surveyor's Michigan License No. 13039