

108TH 1/4 COR.  
SEC. 22

3-29-71

5/4 COR. 108TH

FD - 1/2" REINFORCING ROD  
1' SOUTH OF EXISTING  
CENTER OF ROAD

INTERSECTION OF  
CLARK AND RORTON - SOUTH

NORTH - 29.30' - CENTER 2" STEEL  
COR. POST,

~~N. 60° W - 45.26' - 16" WALNUT~~

~~S. 60° W - 47.45' - 36" OAK~~


~~S. 20° E - 57.18' - 14" B. ELDER~~

4-29-71 - 1891 WITNESSES

SET STONE & BRICK

N. 67° W - 99 1/4 LINKS - 16" B. WALNUT  
65.50'

5-13-71 - DUG UP 1/2" REINFORCING  
ROD - FOUND 1" PIPE BURIED  
2' BELOW SURFACE OF ROAD.  
WITH BROKEN BRICK AND LARGE  
STONE ON WEST SIDE OF 1" PIPE  
RAISED 3/4" COPPERWELD ROD.  
SET MON. BOX, - 1' SOUTH OF ROAD

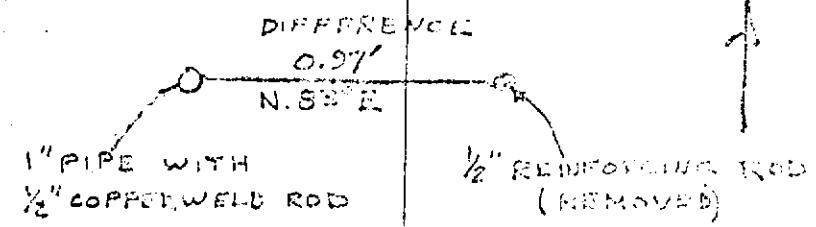

N. 55° W - 44.56' - 16" WALNUT

S. 55° W - 44.61' - 36" OAK

S. 30° E - 57.52' - 14" B. ELDER

NORTH - 29.51' - CENTER 2" STEEL  
COR. POST