

(23)

SOUTH 1/2 COR
SEC. 24

N 1/4 COR SEC. 24

INTERSECTION OF
STOLL AND PEACOCK - CENTER

FD - 1/2" PIPE - 5-17-71 REMOVED

~~N. 35° W - 45.10' - 21" OAK~~

~~N. 50° E - 32.53' - S.W. COR. OF METAL
ROAD SIGN POST,~~


~~N. 10° E - 112.45' - 21" OAK~~

5-18-71 - FOUND 1" PIN w/ 1 1/2" x 4"

PIECE OF PIPE ON TOP OF PIN.

BURIED 1' BELOW SURFACE
OF ROAD, AND 3' SOUTH OF
1/4 OF STOLL RD. AND 2' EAST
OF 1/4 OF PEACOCK RD. SET
LARGE STONES AROUND PIN.
SET MON BOX.

DIFFERENCE

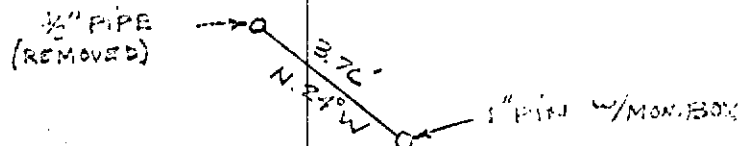

N. 50° W - 48.73' - 21" OAK

N. 40° E - 33.63' - S.W. COR. - METAL ROAD
SIGN POST

N. 12° E - 112.45' - 21" OAK