

(57)

3-21-71

CENTER OF SEC. 25

FD - 3/4" PINCH PIPE - BURIED 03'
IN EXISTING CENTER OF ROAD.
5-18-71 - REMOVED ✓

N. 70° E	18.26	32" OAK
EAST	21.52	TOP FACE - 8" STEEL FE POST
WEST	37.00	3/8" REINFORCING ROD IN GROUND


Hwy Plans . 1" Iron - 1955 ✓
113.52 ✓

N 60° E	11.35	30" Walnut
West	194.3	24" Elm
S 75° W	201.5	32" Maple

BELIEVE THIS IS THE CORNER. (58)

5-14-71 - DUG HOLE FROM M.D.S. WITNESSED - FOUND 3/4" PIPE FLUSH WITH ROAD AND ON EAST E.M. OF ROAD. STRAIGHTENED PIPE AND SET MON. BOX WITH STAKES AROUND. (DIDN'T PULL OTHER CORNER)

DIFFERENCE

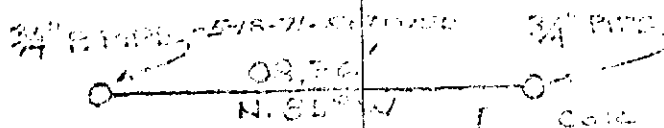

N. 60° E	11.35	31" WALNUT
EAST	13.26	TOP FACE - 8" STEEL FE POST
WEST	41.31	3/8" REINFORCING ROD IN GROUND