


(3)

S.W. COR-SEC 25
COMMON TO SEC'S 26, 35 & 37

WITNESSES IN TREES
NO FIND -

M.S.H.D. with old Plans
COR. 15 Pointed Stone

N. 61° W - 29.82' - 30" oak
S. 25° E - 33.4' - 10" B.E.
S. 36° W - 32.9' - 30" oak

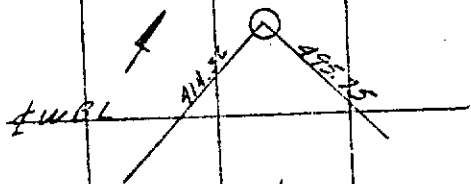

4-30-71 - STONE 33' NORTH AND 33' SOUTH

(4)

5-14-71 - DUG HOLE FROM M.D.S.H.
WITNESSES AND FOUND 1" PIN
BURIED 1' BELOW SURFACE. ON
NORTH E.M. OF ROAD.
SET MON. BOX, 4" STONES AROUND.

N. 61° W - 29.72' - 34" OAK
S. 25° E - 33.40' - 21" BOX ELDER
S. 32° W - 33.00' - 34" OAK
S. 15° W - 100.22' - N.E. COR OF FOND.
HOUSE (?) EACH'S GIFT

SEPT 25-1929 WITNESSES
LARGE STONE - POINTED END UP
10" ASH - S. 01° - 15' W. - 94.1'
15" W. OAK - N. 61° W - 29.5'
18" R. OAK - S. 32° W - 32.6'
6" HICKORY - S. 75° W. - 114.0'