

LAND CORNER RECORDATION CERTIFICATE
Filing Requirement of Act 74, Mich. P.A. 1970

For corners in
Clinton
(County)

Located In:

Corner Code ≠#

- | | | | | |
|------------------------------------|-------------|-------------|-------------|------------|
| 1. Public Land Survey | S <u>24</u> | T <u>5N</u> | R <u>1W</u> | <u>M-8</u> |
| | | T _____ | R _____ | _____ |
| | | T _____ | R _____ | _____ |
| | | T _____ | R _____ | _____ |
| 2. Property Controlling in Section | S _____ | T _____ | R _____ | _____ |
| | S _____ | T _____ | R _____ | _____ |
| 3. Miscellaneous Property in Sec. | S _____ | T _____ | R _____ | _____ |
| | S _____ | T _____ | R _____ | _____ |

Register of Deeds Stamp & File Number

4. Lot No. _____, Recorded Plat _____
 5. Private Claims _____

I, Donald L. Bissell, in a field survey on December, 1987, do hereby certify that under requirements of P.A. 74, Michigan P.A. of 1970, the corner points mentioned in lines 1 and 2 above were in conformance with regulations and rules therefore as required in the current manual of survey instructions of the United States Department of the Interior, Bureau of Land Management or by a decree of a Court of Law and/or that the corner points mentioned in lines 3, 4 and 5 above were in conformance with the rules of the Michigan Board of Land Surveyors or by a Decree of a Court of Law; established, re-established, monumented, re-monumented, recovered, found as expressed below:

	A	B	C	D	E	F	G	H	I	J	K	L	M
2	6	5	4	3	2	1							
3													
4	7	8	9	10	11	12							
5													
6	18	17	16	15	14	13							
7													
8	19	20	21	22	23	24							
9													
10	30	29	28	27	26	25							
11													
12	31	32	33	34	35	36							
13													

NOTE: Not more than 4 corners, all in the same town and range, may be recorded on this certificate.

A. Description of original monument and accessories and/or subsequent restoration:

B. Description of corner evidence found and/or method applied in restoring or reestablishing corner:

M-8 E 1/4 corner
 Set 4" x 36" concrete mon. at
 intersection of old fences
 North-South and West.


C. Description of monument for corner and accessories established to perpetuate locating the position of the corner:

M-8 E 1/4 corner
 N 30°E - 24.40' - 6" Maple
 S 78°E - 20.21' - 5" Maple
 S 83°W - 27.18' - 6" W. Ash
 N 21°W - 7.78' - 10" Maple

Signed by Donald L. Bissell

Date _____

Surveyor's Michigan License No. 18655

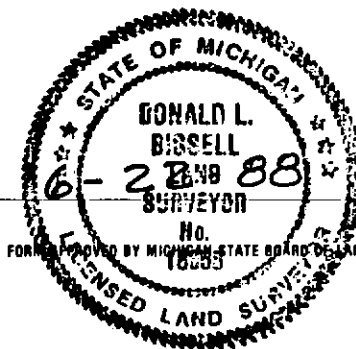

FORM APPROVED BY MICHIGAN STATE BOARD OF LAND SURVEYORS, JAN. 28, 1971
 REVISED MAY 14, 1975
 REVISED JAN., 1983