


(2)

CO. WITNESSES
 1" Gal PIPE C'down.
 AD JACINT TO STONE
 S 32°W 15" MAPLE 70.8'
 S 61°E 1" PIPE 49.0'
 N 24°W 3 1/2" OAK 73.3'

5-12-71 - FOUND 1" PIPE w/ LARGE STONE ALONGSIDE. 3' SOUTH OF ϕ OF CLARK RD AND ON ϕ OF CENTER RD. BURIED 1 1/2' BELOW SURFACE. RAISED w/ 1/2" COPPERWELD ROD. REMOVED REINFORCING ROD.
 N. 35°W - 67.69' P. POLE
 S. 35°E - 193.1' 12" CHERRY
 N. 36°E - 52.81' P. POLE

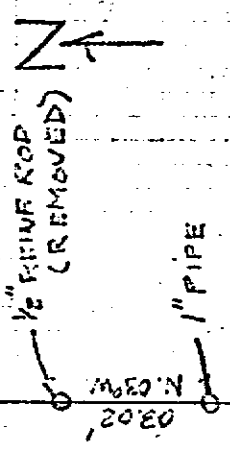

3-29-71

N.E. COR. SEC. 21
 COMMON TO SECS. 22, 15 & 16
 FD - 1/2' ROD - REINFORCING
 1/2' SOUTH OF EXISTING
 CENTER OF ROAD
 REMOVED 1/2" REINFORCING ROD - 5-12-71
 INTERSECTION OF
 CENTER AND CLARK

~~S. 35°E - 51.85' 12" CHERRY
 N. 36°E - 57.1' P. POLE
 N. 40°W - 55.24' P. POLE~~

4-29-71 - 1891 WITNESSES

STONE w/ CROCKERY
 N. 24°W - 109 1/2' LINKS - 20" OAK 72.11'
 S. 34°E - 77 1/2' LINKS - 4" BUTTER NUT 51.32'

G-7
 T5N, R1W
 MDSH NOTES