



(45)

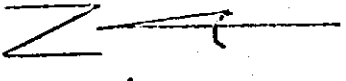

A-8  
T5N, R1W  
MDSH NOTES

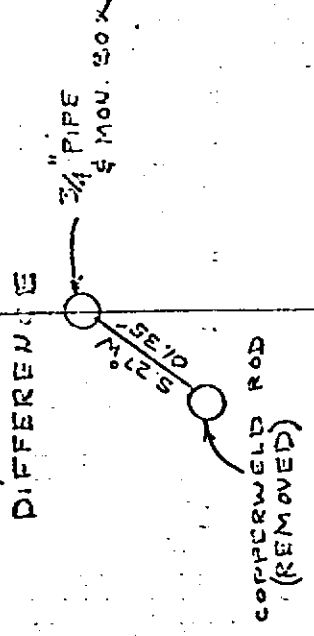

3-30-71

WEST 1/4 COR.  
SEC. 19

INTERSECTION OF  
DRUMHELLER AND CHANDLER

GOT PULL-DIG LATER

4-15-71 - FOUND R.R. SPIKE JUST  
BELOW SURFACE OF BIT  
IN CENTER OF CHANDLER AND  
DRUMHELLER. REMOVED R.R. SPIKE,  
REPLACED w/ 1/2" COPPERWELD ROD.

4-7-71 - DUG HOLE-REMOVED COPPERWELD ROD  
FOUND 5/8" REINFORCING ROD  
3' BELOW SURFACE OF BIT  
ROAD IN 4 OF ROAD. SET 1"  
TILE AROUND ROD. RAISED  
ROD w/ 3/4" PIPE. SET MON. BOX.

N. 35° W. - 80.91' - 16" MAPLE  
S. 45° W. - 44.78' - T. POLE  
S. 50° E - 60.29' - GUY POLE  
N. 55° E - 64.75' - PLAT MON.-BEHIND POLE

(47)