

JAN 17 1996

REMONUMENTATION
SECTION 7, DEWITT TOWNSHIP
COMMISSION LAND CORNER RECORDATION CERTIFICATE
Filing Requirement of Act 74, Mich. P.A. 1970

RECORDED

For corners in

Clinton
(County)

Located In:

Corner Code #

- | | | | | | | |
|---|---|-----------|---|-----------|------------|-------|
| 1. Public Land Survey | T | <u>5N</u> | R | <u>2W</u> | <u>A-3</u> | |
| | T | _____ | R | _____ | _____ | |
| | T | _____ | R | _____ | _____ | |
| | T | _____ | R | _____ | _____ | |
| 2. Property Controlling
In Section | S | _____ | T | _____ | R | _____ |
| | S | _____ | T | _____ | R | _____ |
| 3. Miscellaneous
Property in Section | S | _____ | T | _____ | R | _____ |
| | S | _____ | T | _____ | R | _____ |

DEC 19 2 49 PM '95

REC'D
CLINTON COUNTY MICH.
Arden S. Pierson

LIBER 4, PAGE 110

Register of Deeds Stamp & File Number

4. Lot No. _____, Recorded Plat _____
5. Private Claims _____

A	B	C	D	E	F	G	H	I	J	K	L
2	6		5		4		3		2		
4	7		8		9		10		11		12
5											
6	18		17		16		15		14		13
7											
8	19		20		21		22		23		24
9											
10	30		29		28		27		26		25
11											
12	31		32		33		34		35		36
13											

Arden S. Pierson P.S. in a field survey on September 12, 1995, do hereby certify that under requirements of P.A. 74, Michigan P.A. of 1970, the corner points mentioned in lines 1 and 2 above were in conformance with regulations and rules therefore as required in the current manual of survey instructions of the United States Department of the Interior, Bureau of Land Management or by a decree of a Court of Law and/or that the corner points mentioned in lines 3, 4 and 5 above were in conformance with the rules of the Michigan Board of Professional Surveyors or by a Decree of a Court of Law; established, re-established, monumented, re-monumented, recovered, found as expressed below:

NOTE: Not more than 4 corners, all in the same town and range, may be recorded on this certificate.

A. Description of original monument and accessories and/or subsequent restoration:

Original survey by Hervey Parke in 1827, 82.35 chains Intersected Range Line 22 links North; 14" Lynn - N62°W - 21 links; 7" Lynn - S40°E - 12 links

(OVER)


B. Description of corner evidence found and/or method applied in restoring or reestablishing corner:

Found square head bolt. Accepted as careful and faithful perpetuation of original corner. Replaced with Standard Clinton County Monument and monument box.

Standard Corner - South - 14.52'

(This is an amended closing corner.)

APPROVED BY
CLINTON COUNTY PEER GROUP
DATED 11/8/95
J. F. A.

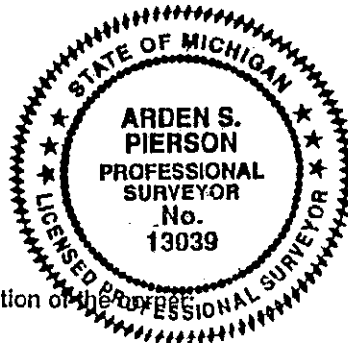

C. Description of monument for corner and accessories established to perpetuate locating the position of the corner:

NW Corner, Section 7

- *Standard Clinton County Monument in monument box
- Nail & Tag #25832 in SE Side Telephone Pole - S24°W - 172.85'
- Nail & Tag #25832 in SW Side Guy Pole - S20°E - 75.71'
- Nail & Tag #13039 in NW Side Power Pole - N80°E - 29.65'
- Nail & Tag #13039 in NE Side Guy Pole - N21°W - 78.49'

*Standard Clinton County Monument is a 2½" dia. steel tube 30" long with a stamped brass cap and a breakaway magnetic base.

Signed by Arden S. Pierson

Date October 28, 1995

Surveyor's Michigan License No. 13039

Certified Boundary Survey Liber 1, Page 293, dated February 5, 1973 by Ron Helsel, PS, #18994.

Square head bolt
Power Pole - N75°E - 39.88'
Power Pole - S60°E - 66.57'
18" Willow - S30°W - 117.22'

South 14.52' Monument Box 1/2" Iron - NE Corner
Section 12, Watertown Township

Certified Boundary Survey Liber 1, Page 519, dated August 19, 1974 by Ron Helsel, PS, #18994, indicated corner recorded in LCRC Liber 1, Page 619.

Certified Boundary Survey Liber 2, Page 364, dated March 24, 1978 by Richard Steadman # 11370.

Indicates closing corner 14.52' North of Standard
Corner with witnesses.

Square head bolt
Power Pole - N75°E - 39.88'
Power Pole - S60°E - 66.57'
18" Willow - S30°W - 117.22'

Certified Boundary Survey Liber 2, Page 639, dated April 27, 1981, by Richard Steadman #11370.

Indicates NW Corner Section 7, T5N, R2W
Power Pole - N75°E - 39.88'
12" Ash - S60°E - 66.57'
18" Willow - S30°W - 117.22'

Certified Boundary Survey Liber 2, Page 824, dated August 9, 1984 by Marvin F. Fouty #18989.

Indicates closing corner at NW Corner Section 7, T5N, R2W,
with witnesses - square bolt head (found).

Power Pole - N75°E - 39.88'
Monument Box with 1/2" Iron Marking
NE Corner Section 12, Watertown Township South 14.52'
Power Pole - S60°E - 66.57'
18" Willow - S30°W - 117.22'