

**SURVEY &
REMONUMENTATION**

FEB 02 1998

REMONUMENTATION

SECTION

SECTION 5, DEWITT TOWNSHIP

LAND CORNER RECORDATION CERTIFICATE

Filing Requirement of Act 74, Mich. P.A. 1970

LIBER 004 PAGE 221

For corners in

Clinton
(County)

Located In:

Corner Code #

1. Public Land Survey	T	<u>5N</u>	R	<u>2W</u>	<u>E-1</u>
	T		R		
	T		R		
	T		R		
2. Property Controlling in Section	S		T	R	
	S		T	R	
3. Miscellaneous Property in Sec.	S		T	R	
	S		T	R	

RECORDED

Oct 17 9 19 AM '97

REGISTER OF DEEDS
CLINTON COUNTY, MICH.
Edwin M. Stanley

Register of Deeds Stamp & File Number

4. Lot No. _____, Recorded Plat _____
5. Private Claims _____

1	A	B	C	D	E	F	G	H	I	J	K	L	M
2		6		5		4		3		2		1	
3													
4		7		8		9		10		11		12	
5													
6		18		17		16		15		14		13	
7													
8		19		20		21		22		23		24	
9													
10		30		29		28		27		26		25	
11													
12		31		32		33		34		35		36	
13													

I, Arden S. Pierson, PS, in a field survey on July 23 19 97, do hereby certify that under requirements of P.A. 74, Michigan P.A. of 1970, the corner points mentioned in lines 1 and 2 above were in conformance with regulations and rules therefore as required in the current manual of survey instructions of the United States Department of the Interior, Bureau of Land Management or by a decree of a Court of Law and/or that the corner points mentioned in lines 3, 4 and 5 above were in conformance with the rules of the Michigan Board of Land Surveyors or by a Decree of a Court of Law; established, re-established, monumented, re-monumented, recovered, found as expressed below:

NOTE: Not more than 2 corners, all in the same town and range, may be recorded on this certificate.

A. Description of original monument and accessories and/or subsequent restoration:

◆ Original survey by Hervey Parke, DS, 1826. T5N, R2W, E-1. Intersected town line 40 (26.40') West, witnessed by: W. Oak 22" - S45°E - 35 links; Butternut 20" - S73°W - 1.04 chains.

◆ Survey by H.H. Jenison, County Surveyor, made on the 27-29th days of March, 1878. Witnessed by: W. Oak 24" - S35°E - 81 1/4 links. B. Walnut 8" - N81°W - 1879. 2.204 chains.

(OVER)

APPROVED BY
CLINTON COUNTY PEER GROUP
DATED 8/20/97
J.P.S.

B. Description of corner evidence found and/or method applied in restoring or reestablishing corner:

Found 1/2" rod over 1/2" rod down 2' below asphalt road surface. Accepted 1/2" rod over 1/2" rod as a careful and faithful perpetuation of the amended position of the original corner.

Replaced 1/2" rod over 1/2" rod with Standard Clinton County Monument at the true corner position on the township line, the amended corner was 0.89' North of the true position.

Standard corner for T6N, R2W is East 29.61'

C. Description of monument for corner and accessories established to perpetuate locating the position of the corner:

Northeast Corner, Section 5

*Standard Clinton County Monument and monument box

Nail & tag #13039 in West side Power Pole - S25°W - 155.30'

SE Corner Concrete Fence Post - N50°E - 42.50'


Nail & tag #13039 in NW side Power Pole - N72°E - 71.43'

Nail & tag #13039 in East side 21" Hickory - S03°E - 50.09'

To E-13, T6N, R2W - S89°39'03"E 29.60'

To D-13, T6N, R2W - N89°39'03"W 2610.02'. From solar observations

*Standard Clinton County Monument is a 2 1/2" diameter Steel tube 30" long with a stamped brass cap and a breakaway magnetic base.

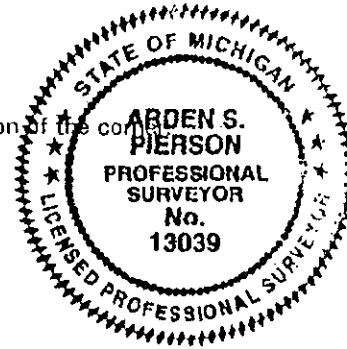

Signed by Arden S. Pierson

Date July 29, 1997

Surveyor's Michigan License No. 13039

- ◆Clinton County Surveyor Field Notes, T5N, R2W, E-1. Witnessed by W. Oak 24" - S35°E - 81¼ links; B. Walnut 8" - N81°W - 2.20¼ chains.
- ◆LCRC by Clyde K. Stephens, PS, #3829, dated December 2, 1971, Liber 1, Page 121. A ½ inch iron rod was found in the centerline of the section line road (Cutler Road) and on a projection of an old farm fence to the south of the corner. Witnessed by:
 Survey tag in a utility pole N69°45'E - 71.80'
 Survey tag in a 12" and 8" Basswood - S33°38'E - 60.35'
 Survey tag in a 12" Hickory - S13°46'E - 55.75'
 The bearing of the section line west of the corner is WEST
- ◆Certificate of Survey by Richard W. Steadman, PS, #11370, dated October 7, 1975, Liber 1, Page 713.
- ◆LCRC by Arden S. Pierson, PS, #13039, dated August 29, 1977, Liber 2, Page 200. NE Section Corner: Recovered Stone previously Recovered by R. Steadman. Raised with ½" rod & cap. Witnessed by:
 S31°E - 56.38' - 8" Ash in clump
 N75°E - 70.24' - Telephone Pole
 S8°E - 51.02' - 12" Hickory
- ◆Certified survey by Richard W. Steadman, PS, #11370, dated May 10, 1978, Liber 2, Page 60.
- ◆Certified survey by Richard W. Steadman, PS, #11370, dated May 18, 1978, Liber 2, Page 59.
- ◆Survey by Hathaway J. Hanes, PS, #5260, dated September 29, 1978, Liber 2, Page 106.
- ◆Certified Survey Map by Marvin Fouty, PS, #18989, dated July 18, 1988, Liber 4, Page 209.
- ◆Certificate of Survey by Douglas K. Richardson, PS, #31603, dated October 4, 1988, Liber 3, Page 427.
- ◆Certificate of Land Survey by Mark L. VanRaemdonck, PS, #24622, dated December 12, 1991, Liber 4, Page 435 & 436.