

SURVEY & REMONUMENTATION

FEB 0 2 1998

SECTION

REMONUMENTATION DEWITT AND OLIVE TOWNSHIP LAND CORNER RECORDATION CERTIFICATE Filing Requirement of Act 74, Mich. P.A. 1970

LIBER 004 PAGE 200
RECORDED

For corners in

Clinton (County) Located in: Corner Code #

1. Public Land Survey
- | | | |
|------|------|------|
| T 6N | R 2W | I-13 |
| T 5N | R 2W | I-1 |
| T | R | |
| T | R | |
2. Property Controlling In Section
- | | | |
|---|---|---|
| S | T | R |
| S | T | R |
3. Miscellaneous Property in Sec.
- | | | |
|---|---|---|
| S | T | R |
| S | T | R |
4. Lot No. _____ Recorded Plat _____
5. Private Claims _____

Oct 17 9 17 AM '97

REGISTER OF DEEDS
CLINTON COUNTY, MICH.
Ann Woodley

Register of Deeds Stamp & File Number

	A	B	C	D	E	F	G	H	I	J	K	L	M
2	6	5	4	3	2	1							
3													
4	7	8	9	10	11	12							
5													
6	18	17	16	15	14	13							
7													
8	19	20	21	22	23	24							
9													
10	30	29	28	27	26	25							
11													
12	31	32	33	34	35	36							
13													

I, Mark L. VanRaemdonck, in a filed survey on August 21, 1997, do hereby certify that under requirements of P.A. 74, Michigan P.A. of 1970, the corner points mentioned in lines 1 and 2 above were in conformance with regulations and rules therefore as required in the current manual of survey instructions of the United States Department of the Interior, Bureau of Land Management or by a decree of a Court of Law and/or that the corner points mentioned in lines 3, 4 and 5 above were in conformance with the rules of the Michigan Board of Land Surveyors or by a Decree of a Court of Law; established, re-established, monumented, re-monumented, recovered, found as expressed below:

NOTE: Not more than 2 corners, all in the same town and range, may be recorded on this certificate.

A. Description of original monument and accessories and/or subsequent restoration:

- Original: Lucius Lyons 1/18/1827
Mon: Wood Post
Access: W. Oak 9 N59 1/2°E 33
DO 13 N46°W 20
- Fred N. White L. C. R. C. 4-17-72
Set corner by proportional measurement from adjoining corners and lines.
Mon: Set Nail & Tag
Access: 20" Hickory N15°E 60.05'
15" Maple N40°W 49.70'
Power Pole S50°W 47.05'
- Ron Helsel, Cert. Survey L. 1, P. 432 11/20/73
Set corner by proportional measurement from adjoining corners and lines.
Mon: Set Nail & Tag
Access: 20" Hickory N15°E 60.05'
- Richard Steadman, Cert. Survey L. 1, P. 474 11/01/73
Mon: Nail & tag
Access: 20" Hickory N15°E 60.05'
15" Maple N40°W 49.70'
Power Pole S50°W 47.05'
- Ron Helsel, Cert. Survey, L. 1, P. 520, 5/15/74
Set corner by proportional measurement from adjoining corners and lines.
Mon: Set Nail & Tag
Access: 20" Hickory N15°E 60.05'
15" Maple N40°W 49.70'
Power Pole S50°W 47.05'

(continued on reversed side of this sheet)

B. Description of corner evidence found and/or method applied in restoring or re-establishing corner:

Found Rerod in Mon. Box as referenced in No.'s 2, 9, 10, 11, 12 and 15 above. I accepted this position as the careful and faithful re-establishment of the original corner position.


C. Description of monument for corner and accessories to perpetuate locating the position of the corner

Removed rerod and replaced it with a STD Clinton County Remonumentation Monument. The monument is witnessed by the following accessories:
N20E 59.41' Nail & Tag #24622 in SE face 30" Hickory
N30W 48.93' Nail & Tag #24622 in E. face 30" Maple
N60W 56.47' Nail & Tag #24622 in E. face 24" Hickory
S45W 46.82' Nail & Tag #13039 in SE face Util Pole
N89°41'13"W 2634.34' STD Clinton County Mon at H-13, T6N-R2W
S89°43'15"E 2622.48' STD Clinton County Mon at J-13, T6N-R2W

Signed by Mark L. VanRaemdonck

Date SEPT 8, 1997

Surveyor's Michigan License No. 24622

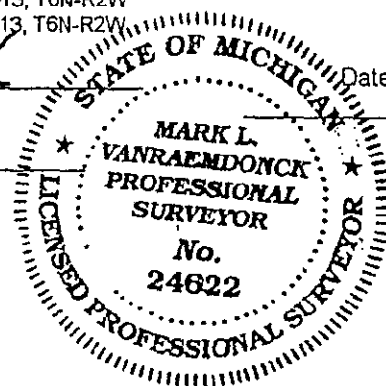

FORM APPROVED BY MICHIGAN STATE BOARD OF LAND SURVEYORS
JAN 18, 1971
REVISED MAY 14, 1975
REVISED JAN 1983

APPROVED BY
CLINTON COUNTY PEER GROUP
DATED 8/13/97

Ann Woodley

JFR

A. Description of original monument and accessories and/or subsequent restoration:

LIBER 004 PAGE 201

(continued from front)

6. Marvin Fouty, Cert. Survey, L. 1, P. 688 6/6/75
 Mon: Found Nail & tag
 Access: 20" Hickory N15°E 60.05'
 15" Maple N40°W 49.70'
 Power Pole S50°W 47.05'
7. Ron Helsel, Cert. Survey, L. 1, P. 738 1/13/7
 Set corner by proportional measurement from adjoining corners and lines.
 Mon: Set Nail & Tag
 Access: 20" Hickory N15°E 60.05'
 15" Maple N40°W 49.70'
 Power Pole S50°W 47.05'
8. Fred N. White, Cert. Survey, L. 2, P. 451 11/4/81
 Set corner by proportional measurement from adjoining corners and lines.
 Mon: Set Nail & Tag
 Access: 20" Hickory N15°E 60.05'
 15" Maple N40°W 49.70'
 Power Pole S50°W 47.05'
9. Kay Don Fluke, L. C. R. C. L. 1, P. 398 10/6/81
 Mon: Found 3/8" Rod in Mon. Box
 Access: N30°E 60.10' Nail & tag in 26" Hickory
 N30°W 49.73' Nail & tag in 20" Maple
 N50°W 57.03' Nail & tag in 19" Maple
 S30°W 46.82' Tele. pole Cap #12034
10. Edwin Morse L. C. R. C., L. 2, P. 305, April, 1980
 Mon: 3/8" Rerod in Mon. Box
 Access: N30°E 60.10' Nail & tag in 26" Hickory
 N30°W 49.73' Nail & tag in 20" Maple
 N50°W 57.03' Nail & tag in 19" Maple
 S30°W 46.82' RLS tag 12034 in a tele. pole
11. Mark VanRaemdonck, Cert. Survey, L. 2, P. 9214/14/86
 Mon: Found empty Mon. Box, Chisled and in center
 Access: S25°E 58.70' R. R. Spike in S. face 24" Hickory
 S50°W 46.72' N&T SE face T. P.
 S25°E 39.80' W. edge road sign post
 N40°E 33.25' W. edge road sign post
12. Ronnie Lester, Cert. Survey, L. 2, P. 439 9/13/86
 Mon: Bar in Mon. Box
 Access: Nail & tag in West side 30" Hickory NE 59.9'
 Nail & tag in East side 30" Maple NW 48.7'
 Nail & tag in West side 20" Maple WNW 57.0
 NE corner garage foundation SW 129.2
13. Douglas K. Richardson, Cert. Survey L. 3, P. 197 2/6/87
 Mon: Found 3/8" Rod in Mon. Box
 Access: N30°E 60.10' Nail & tag in 26" Hickory
 N30°W 49.73' Nail & tag in 20" Maple
 N50°W 57.03' Nail & tag in 19" Maple
 S30°W 46.82' Tele. pole Cap #12034
14. Douglas K. Richardson, Cert. Survey L. 3, P. 283, 4/20/88
 Mon: Found 3/8" Rod in Mon. Box
 Access: N30°E 60.10' Nail & tag in 26" Hickory
 N30°W 49.73' Nail & tag in 20" Maple
 N50°W 57.03' Nail & tag in 19" Maple
 S30°W 46.82' Tele. pole Cap #12034
15. Larry Bryan, Cert. Survey L. 3, P. 225 7/14/88
 Mon: 1/2" Bar in Mon. Box
 Access: Nail & tag in West side 30" Hickory NE 59.9'
 Nail & tag in East side 30" Maple NW 48.7'
 Nail & tag in West side 20" Maple W. NW 57.0'
16. Douglas K. Richardson, Cert. Survey L. 3, P. 436, 12/2/88
 Mon: Found 3/8" Rod in Mon. Box
 Access: N30°E 60.10' Nail & tag in 26" Hickory
 N30°W 49.73' Nail & tag in 20" Maple
 N50°W 57.03' Nail & tag in 19" Maple
 S30°W 46.82' Tele. pole Cap #12034
17. Douglas K. Richardson, Cert. Survey L. 3, P. 435, 12/2/88
 Mon: Found 3/8" Rod in Mon. Box
 Access: N30°E 60.10' Nail & tag in 26" Hickory
 N30°W 49.73' Nail & tag in 20" Maple
 N50°W 57.03' Nail & tag in 19" Maple
 S30°W 46.82' Tele. pole Cap #12034
18. Arden Pierson, Cert. Survey L. 3, P. 907, 4/14/90
 No Mon. or Access. Given
19. Arden Pierson, Cert. Survey L. 4, P. 175, 6/23/89
 No Mon. or Access. Given
20. Ron Helsel, Cert. Survey L. 4, P. 170, 4/23/90
 Mon: Mon. Box
 Access: N30°E 60.10' N&T 26" Hickory
 N30°W 49.73' N&T 20" Maple
 N50°W 57.03' N&T 20" Maple
 S30°W 46.82' N&T Power Pole