

**SURVEY &
REMONUMENTATION**

APR 27 1995 SE CORNER OF SECTION 1, DEWITT TWP.

COMMISSION

**LAND CORNER RECORDATION CERTIFICATE
Filing Requirement of Act 74, Mich. P.A. 1970**

For corners in
Clinton
(County)

Located In:

Corner Code #

- | | | |
|---------------------------------------|-------------------------|------------|
| 1. Public Land Survey | T <u>5N</u> R <u>2W</u> | <u>M-3</u> |
| | T _____ R _____ | _____ |
| | T _____ R _____ | _____ |
| | T _____ R _____ | _____ |
| 2. Property Controlling in Section | S _____ T _____ R _____ | _____ |
| | S _____ T _____ R _____ | _____ |
| 3. Miscellaneous Property in Sec. | S _____ T _____ R _____ | _____ |
| | S _____ T _____ R _____ | _____ |
| 4. Lot No. _____, Recorded Plat _____ | | |
| 5. Private Claims _____ | | |

RECORDED

LIBER 4, PAGE 46

DEC 12 12 00 PM '94

REGISTER OF DEEDS
CLINTON COUNTY, MICH.

Arden S. Pierson

Register of Deeds Stamp & File Number

Arden S. Pierson PS. in a field survey on March 14, 19 94, do hereby certify that under requirements of P.A. 74, Michigan P.A. of 1970, the corner points mentioned in lines 1 and 2 above were in conformance with regulations and rules therefore as required in the current manual of survey instructions of the United States Department of the Interior, Bureau of Land Management or by a decree of a Court of Law and/or that the corner points mentioned in lines 3, 4 and 5 above were in conformance with the rules of the Michigan Board of Land Surveyors or by a Decree of a Court of Law; established, re-established, monumented, re-monumented, recovered, found as expressed below:

NOTE: Not more than 4 corners, all in the same town and range, may be recorded on this certificate.

	A	B	C	D	E	F	G	H	I	J	K	L	M
2	6	5	4	3	2	1							
3													
4	7	8	9	10	11	12							
5													
6	18	17	16	15	14	13							
7													
8	19	20	21	22	23	24							
9													
10	30	29	28	27	26	25							
11													
12	31	32	33	34	35	36							
13													

A. Description of original monument and accessories and/or subsequent restoration:


M-3 - Original survey by Harvey Parke DS, 1826. County Surveyor records show in survey by R.H. Colburn, in September of 1884, that he located the original corner and placed a large stone witnessed by:
30" W. Oak stump -N35°45'W- 20 links

B. Description of corner evidence found and/or method applied in restoring or reestablishing corner:

Section 1, Dewitt Township

M-3 - Found 1/2" iron in centerline of Howe Road. And accepted as a careful and faithful reestablishment of the position of the original corner. Replaced 1/2" iron with Standard Clinton County Monument set in monument box. Verified position from closing distance from closing corner. (Bath Twp. corner)

APPROVED BY
CLINTON COUNTY PEER GROUP
DATED 11/9/94
J.P.

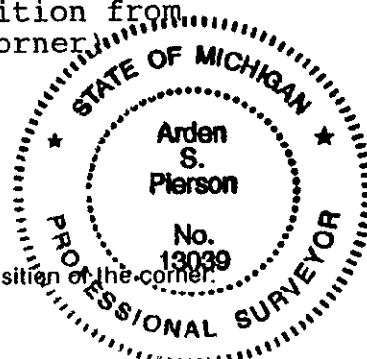

C. Description of monument for corner and accessories established to perpetuate locating the position of the corner:

**M-3 (SE corner of Section 1)
Clinton County Monument**

Clinton County Monument (SW corner Section 6, T5N,R1W) -South- 33.74'
Nail & tag SE side 30" Oak -S50°W- 96.00'
Face of concrete anchor post -N40°W- 39.63'
Nail & tag NW side 14" Oak -N85°E- 62.60'
Nail & tag SW side 30" Maple -S50°E- 96.29'

*Standard Clinton County Monument is a 2 1/2" dia. steel tube 30" long with a stamped brass cap and breakaway magnetic base.

December 7, 1994

Signed by Arden S. Pierson

Date _____

Surveyor's Michigan License No. 13039