

FEB 13 1999

CLINTON COUNTY REMONUMENTATION
SECTION CORNER COMMON TO SECTIONS 13 & 24,
T5N, R2W, DEWITT TOWNSHIP, CLINTON COUNTY, MICHIGAN
LAND CORNER RECORDATION CERTIFICATE
Filing Requirement of Act 74, Mich. P.A. 1970

LIBER 004 PAGE 293
RECORDED

For corners in
CLINTON
(County)

Located In: _____ Corner Code # _____

1. Public Land Survey T 5N R 2W M-7
T _____ R _____
T _____ R _____
T _____ R _____

2. Property Controlling S T R
In Section S T R
3. Miscellaneous S T R
Property in Sec. S T R

4. Lot No. _____, Recorded Plat _____

5. Private Claims _____

Dec 28 3 40 PM '98

REGISTER OF DEEDS
CLINTON COUNTY, MICH.
Arden S. Pierson

Register of Deeds Stamp & File Number

I, Arden S. Pierson, PS, in a field survey on SEPTEMBER 17 19 98, do hereby certify that under requirements of P.A. 74, Michigan P.A. of 1970, the corner points mentioned in lines 1 and 2 above were in conformance with regulations and rules therefore as required in the current manual of survey instructions of the United States Department of the Interior, Bureau of Land Management or by a decree of a Court of Law and/or that the corner points mentioned in lines 3, 4 and 5 above were in conformance with the rules of the Michigan Board of Land Surveyors or by a Decree of a Court of Law; established, re-established, monumented, re-monumented, recovered, found as expressed below:

	A	B	C	D	E	F	G	H	I	J	K	L	M
1													
2	6	5	4	3	2	1							
3													
4	7	8	9	10	11	12							
5													
6	18	17	16	15	14	13							
7													
8	19	20	21	22	23	24							
9													
10	30	29	28	27	26	25							
11													
12	31	32	33	34	35	36							
13													

NOTE: Not more than 4 corners, all in the same town and range, may be recorded on this certificate.

A. Description of original monument and accessories and/or subsequent restoration:
TOWNSHIP BOUNDARY SURVEY BY LUCIUS LYON IN 1826.
NORTH ON EAST BOUNDARY SECTION 24 - 80.00 SET POST CORNER TO SECTIONS 13 & 24,
11" B. OAK - S17½°W - 19 (12.54'), 7" W. OAK - N46°W - 61 (40.26')

-OVER-

B. Description of corner evidence found and/or method applied in restoring or reestablishing corner:
FOUND 5/8" ROD IN MONUMENT BOX IN PHYSICAL CENTERLINE OF CHANDLER ROAD (25' NORTH OF CLARK ROAD) AS IS ACCEPTED AS A CAREFUL AND FAITHFUL RE-ESTABLISHMENT OF THE POSITION OF THE ORIGINAL CORNER.

REMOVED 5/8" ROD AND PLACED STANDARD CLINTON COUNTY MONUMENT.

C. Description of monument for corner and accessories established to perpetuate locating the position of the corner:

SECTION CORNER COMMON TO SECTIONS 13 & 24, T5N, R2W.
STANDARD CLINTON COUNTY MONUMENT IN MONUMENT BOX.


WITNESSES

NAIL & TAG #13039 IN E. SIDE POWER POLE - S45°W - 76.16'
NAIL & TAG #13039 IN N. SIDE POWER POLE - N66°W - 35.60'
NAIL & TAG #13039 IN SW SIDE POWER POLE - S33°E - 79.19'
CORNER A-7, BATH - SOUTH - 36.26'

FROM SOLAR OBSERVATIONS

N00°13'53"W 2639.71' - M-6, DEWITT TOWNSHIP
S00°06'04"E 36.26' - A-7, BATH TOWNSHIP

*STANDARD CLINTON COUNTY MONUMENT IS A 2½" DIAMETER STEEL TUBE 30" LONG WITH A STAMPED BRASS CAP AND A BREAKAWAY MAGNETIC BASE.

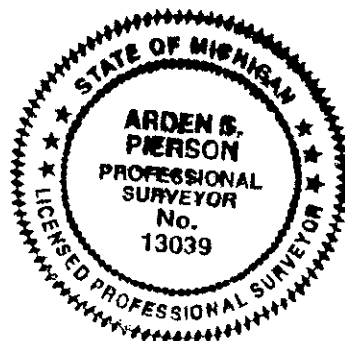

Signed by Arden S. Pierson

Date SEPTEMBER 21, 1998

Surveyor's Michigan License No. 13039

APPROVED BY
CLINTON COUNTY PEER GROUP
DATED 9/23/98
J 709

SECTION CORNER COMMON TO SECTIONS 13 & 24, M-7, DEWITT TOWNSHIP

LCRC. LIBER 001, PAGE 951, DATED 8/14/75, BY MAYNARD R. DYER, PS #21565,
SET ON TOWNLINE AT GLO. FALLING FROM NW. CORNER OF SECTION 19, T5N, R1W.
SET ½" BAR & CAP IN APPARENT CENTERLINE OF CHANDLER ROAD, 25.71 NORTH OF
APPARENT CENTERLINE OF CLARK ROAD.

NAIL & TAG IN NORTH SIDE OF POWER POLE - SW - 80.34'

NAIL & TAG IN SW SIDE POWER POLE - SE - 79.35'

NW CORNER SECTION 19, T5N, R1W, SOUTH 36.30'

LCRC. LIBER 2, PAGE 452, DATED 7/19/82, BY KAY DON FLUKE, PS #18988 (MDOT)
FOUND ½ STEEL ROD WITH RLS CAP IN CENTERLINE OF CHANDLER ROAD, SET MON. BOX.
OVER STEEL ROD & FLUSH WITH BIT SURFACE.

N70°W - 35.65' - SIGNAL LIGHT GUYPOLE


S48°W - 79.38' - TELEPHONE POLE

S25°E - 78.96' - TELEPHONE & DOWER POLE

SOUTH - 36.30' - ½" PIPE FLUSH WITH BIT SURFACE

(NW CORNER, SECTION 19, BATH TOWNSHIP, T5N, R1W)

SAME INFORMATION ON MDOT CORNER CARD AND MDOT CONSTRUCTION PLAN WITNESS SHEET.

 

RENTON &
SURVEYING & ENGINEERING

FEB 1 1993

SECTION