

JAN 27 2000

Clinton County Remonumentation
West 1/4 Corner Section 6, T.5 N.-R.3 W., Watertown Township
LAND CORNER RECORDATION CERTIFICATE
Filing Requirement of Act 74, Mich. P.A. 1970

9/2

For corners in SECTION

Clinton Located In: Corner Code #

(County)

1. Public Land Survey T. 5N R. 3W A-2
T. _____ R. _____
T. _____ R. _____
T. _____ R. _____

2. Property Controlling in Section S. _____ T. _____ R. _____
S. _____ T. _____ R. _____

3. Miscellaneous Property in Sec. S. _____ T. _____ R. _____
S. _____ T. _____ R. _____

4. Lot No. _____, Recorded Plat _____

5. Private Claims _____

LIBER 004 PAGE 349

RECORDED

DEC 21 12 55 PM '99

REGISTER OF DEEDS
CLINTON COUNTY
Register of Deeds Stamp & File Number

1	B	C	D	E	F	G	H	I	J	K	L	M
2	6	5	4	3	2	1						
3												
4	7	8	9	10	11	12						
5												
6	18	17	16	15	14	13						
7												
8	19	20	21	22	23	24						
9												
10	30	29	28	27	26	25						
11												
12	31	32	33	34	35	36						
13												

I, Samuel J. Clark, in a field survey on November 16, 1999, do hereby state that under requirements of P.A. 74, Michigan P.A. of 1970, the corner points mentioned in lines 1 and 2 above were in conformance with regulations and rules therefore as required in the current manual of survey instructions of the United States Department of the Interior, Bureau of Land Management or by a decree of a Court of Law and for that the corner points mentioned in lines 3, 4 and 5 above were in conformance with the rules of the Michigan Board of Land Surveyors or by a Decree of a Court of Law; established, re-established, monumented, recovered, found as expressed below:

NOTE: Not more than 2 corners, all in the same town and range, may be recorded on this certificate.

A. Description of original monument and accessories and/or subsequent restoration:

A-2 West 1/4 Corner, Section 6, Watertown Township
Corner not originally set by G.L.O.
LCRC by Duane A. Ankrom, PS #21265, dated January 14, 1977 and recorded in Liber 002, Page 133
Set re-bar & cap by prop. Meas. On line with SE Corner and NE Corner of Section 1, T5N-R4W
Apple tree clump, N35°W, 39.15'
10" Ash, N40°E, 34.51'
Fence corner post, S15°E, 44.81'

APPROVED BY
CLINTON COUNTY PEER GROUP
DATED 11/10/99
[Signature]

B. Description of corner evidence found and/or method applied in restoring or reestablishing corner:

A-2 West 1/4 Corner, Section 6, Watertown Township
Found 1/2" Rebar
1/2" Bar & Cap (M-1 Eagle Twp.), South, 116.15'
This location is 0.23' south of the location I calculated as the proportionate measure between A-1 and A-3 and therefore I accept this corner as a careful and faithful reestablishment of the position of the corner.


C. Description of monument for corner and accessories established to perpetuate locating the position of the corner:

A-2 West 1/4 Corner, Section 6, Watertown Township

*Set Standard Clinton County Monument with the following witnesses:

Chisel in W. End 36" CMP Culvert, S41°W, 39.78'
Chisel in E. End 36" CMP Culvert, S26°E, 30.37'
Nail & Tag #41096 in NE face 18" Oak, N72°W, 31.96'
M-2 Eagle Twp., South, 116.15'
A-1 Watertown Township N.00°-08'-25"W., 2746.35'
A-3 Watertown Township S.00°-07'-52"E., 2633.51'

Bearings based on a solar observation performed at M-1, Eagle Twp. on November 9, 1999
*Standard Clinton County Monument being a 2 1/2" Diameter Steel Tube, 30" long, with a stamped brass cap, restamped #41096, and breakaway magnetic base.

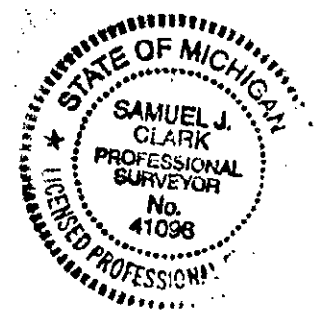

Signed by [Signature] Date 12/20/99


◆ Certificate of Survey by Duane A. Ankrom, PS #21265, dated January 1977, and recorded in Liber 001, Page 869
Set re-bar & cap by prop. Meas. & on line
Apple tree clump, N35°W, 39.15'
10" Ash, N40°E, 34.51'
Fence corner post, S15°E, 44.81'

RECORDED

JAN 27 2000

SECTION