

RECORDED
JAN 27 2000

SECTION Northwest Corner Section 7 and the Southwest Corner of Section 6,
T. 5 N.-R.3 W., Watertown Township
LAND CORNER RECORDATION CERTIFICATE
Filing Requirement of Act 74, Mich. P.A. 1970

For corners in

Clinton _____ (County)	Located In:	Corner Code #
1. Public Land Survey	T <u>5N</u> R <u>3W</u> A- <u>3</u>	
	T _____ R _____	
	T _____ R _____	
	T _____ R _____	
2. Property Controlling in Section	S _____ T _____ R _____	
	S _____ T _____ R _____	
3. Miscellaneous Property in Sec.	S _____ T _____ R _____	
	S _____ T _____ R _____	
4. Lot No. _____, Recorded Plat _____		
5. Private Claims _____		

LIBER 004 PAGE 351

RECORDED

DEC 21 12 55 PM '99

REGISTER OF
CLINTON COUNTY, MICH.

Harold W. Winkler
Register of Deeds Stamp & File Number

I, Samuel J. Clark, in a field survey on November 16, 1999 do hereby state that under requirements of P.A. 74, Michigan P.A. of 1970, the corner points mentioned in lines 1 and 2 above were in conformance with regulations and rules therefore as required in the current manual of survey instructions of the United States Department of the Interior, Bureau of Land Management or by a decree of a Court of Law and for that the corner points mentioned in lines 3, 4 and 5 above were in conformance with the rules of the Michigan Board of Land Surveyors or by a Decree of a Court of Law; established, re-established, monumented, recovered, found as expressed below:

NOTE: Not more than 2 corners, all in the same town and range, may be recorded on this certificate.

	B	C	D	E	F	G	H	I	J	K	L	I
1												
2	6		5		4		3		2		1	
3												
4	7		8		9		10		11		12	
5												
6	18		17		16		15		14		13	
7												
8	19		20		21		22		23		24	
9												
10	30		29		28		27		26		25	
11												
12	31		32		33		34		35		36	
13												

A. Description of original monument and accessories and/or subsequent restoration:

A-3 Northwest Corner Section 7 and Southwest Corner Section 6, Watertown Township
Corner set December, 1826 by Hervey Parke, Deputy Surveyor with the following witnesses:
22" Beech, N16°E, 39 lks. (25.74')
13" Beech, S36 1/2°E, 55 lks. (36.30')
G.L.O. closing distance 1.76 ch. South of M-3, Eagle

APPROVED BY
CLINTON COUNTY PEER GROUP
DATED 11/10/99
S. J. Clark

(Over)

B. Description of corner evidence found and/or method applied in restoring or reestablishing corner:

A-3 Northwest Corner Section and Southwest Corner Section 6, Watertown Township


Found 1/2" Rebar 0.27' East of Township Line
N & T #12034 in SE face utility pole, S12°W, 144.85'
5/8" Rebar (M-3 Eagle Twp.), North, 116.13'

This corner is on the township line and was set by Duane Ankrom in accordance with the 1973 Instructions. Corner accepted as a careful and faithful reestablishment of the position of the original corner.

C. Description of monument for corner and accessories established to perpetuate locating the position of the corner:

A-3 Northwest Corner Section and Southwest Corner Section 6, Watertown Township

*Set Standard Clinton County Monument
N & T #41096 in W. Face wood fence post, S22°E, 51.59'
N & T #12034 in SE face utility pole, S12°W, 144.85'
N & T #41096 in NE face wood fence post, S50°E, 49.68'
A-2 Watertown Township N.00°-07'-52"W., 2633.51'
A-4 Watertown Township S.00°-02'-18"E., 2630.82'
*Standard Clinton County Monument (M-3 Eagle Twp.), North, 116.13'
Bearings based on a solar observation performed at M-1, Eagle Twp. on November 9, 1999
*Standard Clinton County Monument being a 2 1/2" Diameter Steel Tube, 30" long, with a stamped brass cap, restamped #41096, and breakaway magnetic base.

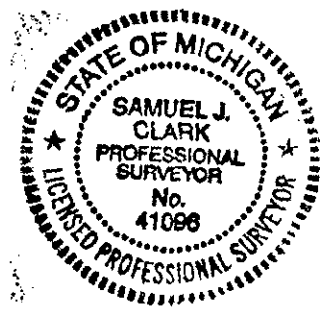

Signed by *Samuel J. Clark*
Surveyor's Michigan License No. 41096

Date 12/20/99

- ◆ LCRC by Duane A. Ankrom, PS #21265, dated January 14, 1977 and recorded in Liber 002, Page 129
Set re-bar & cap 116.16' South of NE corner, Sec. 12, T5N-R4W on line with E 1/4 Corner of Section 12
& NE Corner of Section 1, T5N-R4W
Fence corner post, N15°E, 61.31'
Fence corner post, S80°E, 48.63'
Fence corner post, S20°E, 46.24'
- ◆ Certificate of Survey by Fred N. White, PS #12034, dated June 23, 1982 and recorded in Liber 2, Page 541
Found as recorded in Liber 002, Page 129

RECORDED

JAN 27 2000

SECTION