5/9/94

LAND CORNER RECORDATION CERTIFICATE

Filing Requirement of Act 74, Mich. P.A. 1970

For corners in Clinton (County)

RECORDED

MAR 15 3 38 PM '94

REGISTER OF DEEDS
CLINTON COUNTY, MICH.
Carol Wooley

LIBER 4, PAGE 25

Register of Deeds Stamp & File Number

	Located In:	Corner Code ##
1. Public Land Survey	T 5N R 3W	A-5
	T ___ R ___	
	T ___ R ___	
	T ___ R ___	
2. Property Controlling	S ___ T ___ R ___	
in Section	S ___ T ___ R ___	
3. Miscellaneous	S ___ T ___ R ___	
Property in Sec.	S ___ T ___ R ___	

4. Lot No. _____ , Recorded Plat _____
5. Private Claims _____

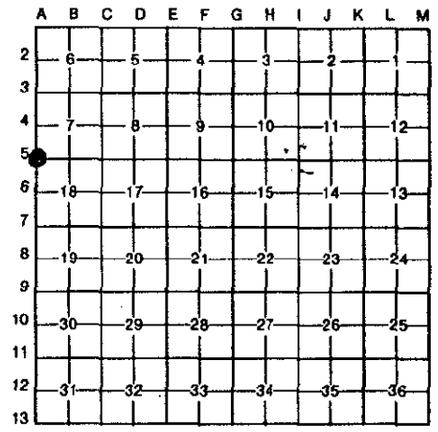

I, Dwight R. Schofield, in a field survey on December 20, 19 93, do hereby certify that under requirements of P.A. 74, Michigan P.A. of 1970, the corner points mentioned in lines 1 and 2 above were in conformance with regulations and rules therefore as required in the current manual of survey instructions of the United States Department of the Interior, Bureau of Land Management or by a decree of a Court of Law and/or that the corner points mentioned in lines 3, 4 and 5 above were in conformance with the rules of the Michigan Board of Land Surveyors or by a Decree of a Court of Law; established, re-established, monumented, re-monumented, recovered, found as expressed below:

NOTE: Not more than 4 corners, all in the same town and range, may be recorded on this certificate.

A. Description of original monument and accessories and/or subsequent restoration:

Original survey December 1826 by Harvey Parke DS
Subsequent restoration recorded by PS 18994 Liber 1, Page 773
3/4" Rebar
N 45° E Nail & Cap #18994 W side of 20" Walnut 69.89'
S 85° W Nail & Cap #18994 N side Power Pole 25.77'
N 20° E Nail & Cap #18994 W side Power Pole 79.87'

B. Description of corner evidence found and/or method applied in restoring or reestablishing corner:

Found 1/2" Rebar over 1" Pipe
S 85° W Nail & Cap #18994 in Power Pole 25.80'

accepted monument as corner location and set Standard Clinton County Monument

C. Description of monument for corner and accessories established to perpetuate locating the position of the corner:

A-5 (NW cor. Section 18)
Standard Clinton County Monument
S 85° W Nail & Cap #18994 W side Power Pole 25.80'
N 20° E Nail & Tag "Consumers" W side Power Pole 81.04'
N 45° W SE cor. @ base, Power riser (1'x1') 46.88'
S 45° E 1/2" Rebar 48.77'

STATE OF MICHIGAN
DWIGHT R. SCHOFIELD
34176
PROFESSIONAL SURVEYOR

APPROVED BY
CLINTON COUNTY PEER GROUP
DATED 1/19/94

Signed by _____ Date January 13, 1994

Surveyor's Michigan License No. 34176

FORM APPROVED BY MICHIGAN STATE BOARD OF LAND SURVEYORS, JAN. 28, 1971
REVISED MAY 14, 1975
REVISED JAN., 1983