

LAND CORNER RECORDATION CERTIFICATE
Filing Requirement of Act 74, Mich. P.A. 1970

For corners in
Clinton
(County)

Located In: _____ Corner Code # _____

RECORDED

- | | | | | | |
|------------------------------------|---|-----------|---|-----------|------------|
| 1. Public Land Survey | T | <u>5N</u> | R | <u>3W</u> | <u>G-9</u> |
| | T | _____ | R | _____ | _____ |
| | T | _____ | R | _____ | _____ |
| | T | _____ | R | _____ | _____ |
| 2. Property Controlling in Section | S | _____ | T | _____ | _____ |
| | S | _____ | T | _____ | _____ |
| 3. Miscellaneous Property in Sec. | S | _____ | T | _____ | _____ |
| | S | _____ | T | _____ | _____ |

MAR 15 3 38 PM '94

REGISTER OF DEEDS
 CLINTON COUNTY, MICH.

Carol Woolley

LIBER 4, PAGE 24

Register of Deeds Stamp & File Number

4. Lot No. _____, Recorded Plat _____
 5. Private Claims _____

Dwight R. Schofield

I, _____, in a field survey on December 20, 19 93, do hereby certify that under requirements of P.A. 74, Michigan P.A. of 1970, the corner points mentioned in lines 1 and 2 above were in conformance with regulations and rules therefore as required in the current manual of survey instructions of the United States Department of the Interior, Bureau of Land Management or by a decree of a Court of Law and/or that the corner points mentioned in lines 3, 4 and 5 above were in conformance with the rules of the Michigan Board of Land Surveyors or by a Decree of a Court of Law; established, re-established, monumented, re-monumented, recovered, found as expressed below:

NOTE: Not more than 4 corners, all in the same town and range, may be recorded on this certificate.

A	B	C	D	E	F	G	H	I	J	K	L	M
2	6	5	4	3	2	1						
3												
4	7	8	9	10	11	12						
5												
6	16	17	16	15	14	13						
7												
8	19	20	21	22	23	24						
9												
10	30	29	28	27	26	25						
11												
12	31	32	33	34	35	36						
13												

A. Description of original monument and accessories and/or subsequent restoration:

Original survey December 1826 by Harvey Parke DS
 County surveyor indicates Sugar 10 N 45° W 70 1/2 as witness.
 Subsequent restoration recorded by PS 2934 Liber 1, Page 275
 Subsequent restoration recorded by PS 13039 Liber 2, Page 188
 5/8" Rod
 S 39° E Power Pole 49.26'
 S 52° W NE cor. of basement of Hse. 101.50'
 N 38° W SE cor of foundation 110.48'


B. Description of corner evidence found and/or method applied in restoring or reestablishing corner:

Found 1/2" Rebar in Monument Box
 S 52° W NE cor. of basement of Hse. #15000 101.50'
 N 38° W SE cor. of foundation of Hse. #14960 110.49'
 S 39° E 'Shiner', #13039 in Power pole 49.22'

Accepted monument as corner location and set Standard Clinton County Monument in Monument Box.

C. Description of monument for corner and accessories established to perpetuate locating the position of the corner:

G-9 (NW cor. Section 27)
 Standard Clinton County Monument in Monument Box
 S 52° W NE cor. of basement of Hse. #15000 101.50'
 N 38° W SE cor. of foundation of Hse. #14960 110.49'
 S 39° E 'Shiner' #13039 in Power Pole 49.22'
 N 60° E Nail & Tag #34976 in S side 30" Maple 65.58'

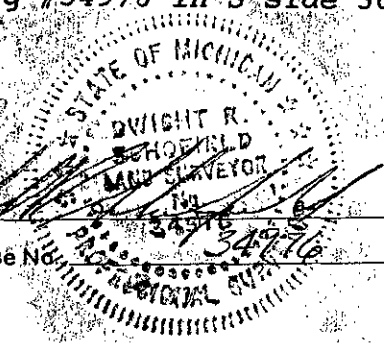

APPROVED BY
 CLINTON COUNTY PEER GROUP
 DATED 1/19/94

Signed by Dwight R. Schofield
 Surveyor's Michigan License No. 34976

Date January 12, 1994