

SURVEY & REMONUMENTATION

FEB 02 1998

**REMONUMENTATION
SECTIONS 33 & 34, WATERTOWN TOWNSHIP**

**LAND CORNER RECORDATION CERTIFICATE
Filing Requirement of Act 74, Mich. P.A. 1970**

SECTION

For corners in

CLINTON
(County)

Located In: Corner Code#

| | | | | |
|------------------------------------|---|-------------|-------------|-------------|
| 1. Public Land Survey | | <u>T 5N</u> | <u>R 3W</u> | <u>G-13</u> |
| | | T | R | |
| | | T | R | |
| | | T | R | |
| 2. Property Controlling in Section | S | T | R | |
| | S | T | R | |
| 3. Miscellaneous Property in Sec. | S | T | R | |
| | S | T | R | |

LIDER 004 PAGE 225

RECORDED

OCT 17 9 19 AM '97

REGISTER OF DEEDS
CLINTON COUNTY, MICH.
David W. ...

Register of Deeds Stamp & File Number

4. Lot No. _____, Recorded Plat _____
5. Private Claims _____

| | A | B | C | D | E | F | G | H | I | J | K | L | M |
|----|----|---|----|---|----|---|----|---|----|---|----|---|---|
| 1 | | | | | | | | | | | | | |
| 2 | 6 | | 5 | | 4 | | 3 | | 2 | | 1 | | |
| 3 | | | | | | | | | | | | | |
| 4 | 7 | | 8 | | 9 | | 10 | | 11 | | 12 | | |
| 5 | | | | | | | | | | | | | |
| 6 | 18 | | 17 | | 16 | | 15 | | 14 | | 13 | | |
| 7 | | | | | | | | | | | | | |
| 8 | 19 | | 20 | | 21 | | 22 | | 23 | | 24 | | |
| 9 | | | | | | | | | | | | | |
| 10 | 30 | | 29 | | 28 | | 27 | | 26 | | 25 | | |
| 11 | | | | | | | | | | | | | |
| 12 | 31 | | 32 | | 33 | | 34 | | 35 | | 36 | | |
| 13 | | | | | | | | | | | | | |

I, Roger P. Mahoney, in a field survey on July 24, 1997 do hereby state that under requirements of P.A. 74, Michigan P.A. of 1970, the corner points mentioned in lines 1 and 2 above were in conformance with regulations and rules therefore as required in the current manual of survey instructions of the United States Department of the Interior, Bureau of Land Management or by a decree of a Court of Law and /or that the corner points mentioned in lines 3, 4 and 5 above were in conformance with the rules of the Michigan Board of Land Surveyors or by a Decree of a Court of Law; established, re-established, monumented, recovered, found as expressed below:

NOTE: Not more than 2 corners, all in the same town and range, may be recorded on this certificate.

A. Description of original monument and accessories and/or subsequent restoration:

G-13 - Southeast Corner Section 33 and Southwest Corner Section 34, T.5N.-R.3W.

Post set by United States Deputy Surveyor, L. Lyons, in 1826
Beech 18" N.61°E. 45 links
Beech 8" N. 81 1/2°W. 37 links

(Over)

APPROVED BY
CLINTON COUNTY PEER GROUP
DATED 8/20/97

gpr

B. Description of corner evidence found and/or method applied in restoring or reestablishing corner:

G-13 - Southeast Corner Section 33 and Southwest Corner Section 34, T.5N.-R.3W.

Found 1" Pipe in Center of Sheridan Road (Eaton Highway) 10' below road surface, dug down 3.0' below road surface, found boat spike bent over point of stone, as noted on state highway plans--Michigan Project EI-96-2(26) 130 State Project EBI 19022 RN C4 & C5, sheet # 5.


Set a Standard Clinton County Monument, being a 2 1/2" diameter steel tube 30" long with a stamped brass cap over stone point and boat spike and is accepted as the best available evidence of the position of the original corner.

C. Description of monument for corner and accessories established to perpetuate locating the position of the corner:

G-13 - Southeast Corner Section 33 and Southwest Corner Section 34, T.5N.-R.3W.

Standard Clinton County Monument, being a 2 1/2" diameter steel tube 30" long with a stamped brass cap.

S.25°E., 27.95'--Top of 1/2" rebar in concrete at North Face angle Iron Anchor Post
S.10°W., 23.51'--Found N&T #16053 in NE side 48" Oak
N.10°W., 30.80'--Found N&T #16053 in East face 15" Oak
East-14.31'--Found 3/4" pipe, G-1, NW Cor. Sec. 3, T.4N.-R.3W., Delta Township, Eaton County.
S.10°E., 36.62'--Set N&T # 41105 in West face 42" Oak.

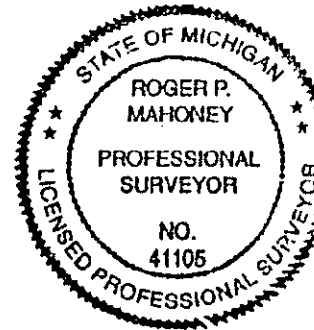

Signed by Roger P. Mahoney
Surveyor's Michigan License No. 41105

Date August 20, 1997

Hwy. Plans--Michigan Project EI-96-2(26) 130, State project EBI 19022 RN C4 & C5; Lansing-Grand Rapids Rd., Sheet 5, Dated 1960. Found boat spike over stone;
 N.10°W., 31.05'-7" Oak
 N.55°W., 30.12'-6" Elm
 S.15°W., 23.93'-30" Oak
 S.10°E., 36.31'-27" Oak

Recd. Survey by R. Steadman, # 11370, July 1974, L.1, P.480, Found boat spike over stone;
 N.5°W., 31.05' -8" Oak
 S.15°W., 23.93'-30" Oak
 S.10°E., 36.31'-27" Oak

Recd. Survey by R. Steadman, # 11370, July 1974, L.1, P.476-477, Found boat spike over stone;
 N.5°W., 31.05' -8" Oak
 S.15°W., 23.93' -30" Oak
 S.10°E., 36.31'-27" Oak

C.R.C. by P. Wetoskey # 19847, approved by D. Hooth, # 7966; June 1976, L.2, P.59, Found 3/8" Iron in center of Eaton Hwy. from witnesses obtained from State Hwy. Plans (File No. 19022-C4);
 N.15°E., 27.76'-Steel Corner Fence Post
 N.15°W., 24.33'-30" Oak
 N.10°W., 30.96'-7" Oak

State Hwy. Plans, Michigan Project I-69-3(33)83, Control Section I 19043, Job Number 18631A, Sheet 10, July 9, 1981, Found 3/8" Iron with survey tag # 11370;
 N.15°W., 24.33'-30" Oak
 N.15°E., 27.76'-Steel Cor. Fence Post
 N.10°W., 30.96'-7" Oak