


N.W. Cor Sec. 36, T.5N. R.3W.

19

● ●

● ●

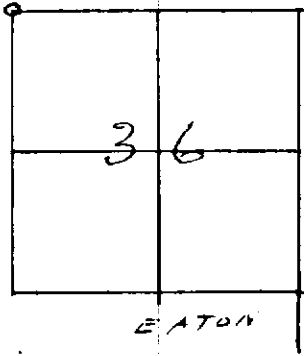

● ● 1" iron pipe

~~West 24.68 P. pole~~

~~N.E. 35.60 24" maple~~

West 69.79 Bolt S.E. side 12" elm

S.W. 55.24 Bolt N.W. side 14" cherry

● ●

1/2" iron rod pt. on W. line sec. 36

N. 24.68' P. pole

● ●

N.E. 35.60 24" maple

● ●

From S.H.R. Copied 5/10/3