

DOCUMENTATION REMONUMENTATION
 SECTION 12, EAGLE TOWNSHIP
 JAN 17 1996 LAND CORNER RECORDATION CERTIFICATE
 Filing Requirement of Act 74, Mich. P.A. 1970

RECORDED

Nov 9 9 03 AM '95

REGISTER OF DEEDS
 CLINTON COUNTY, MICH.
Carol Winkley

For corners in Clinton (County) COMMISSION Located In: Corner Code #

1. Public Land Survey	T	<u>5N</u>	R	<u>4W</u>	<u>K-5</u>
	T		R		
	T		R		
	T		R		
2. Property Controlling in Section	S		T		
	S		T		
3. Miscellaneous Property in Section	S		T		
	S		T		

LIBER 4, PAGE 99

Register of Deeds Stamp & File Number

4. Lot No. _____, Recorded Plat _____
 5. Private Claims _____

	A	B	C	D	E	F	G	H	I	J	K	L	M
2	6		5						3		2		
3													
4	7		6					10		11		12	
5													
6	18		17		16		15		14		13		
7													
8	19		20		21		22		23		24		
9													
10	30		29		28		27		26		25		
11													
12	31		32		33		34		35		36		
13													

Arden S. Pierson P.S. in a field survey on September 15, 1995, do hereby certify that under requirements of P.A. 74, Michigan P.A. of 1970, the corner points mentioned in lines 1 and 2 above were in conformance with regulations and rules therefore as required in the current manual of survey instructions of the United States Department of the Interior, Bureau of Land Management or by a decree of a Court of Law and/or that the corner points mentioned in lines 3, 4 and 5 above were in conformance with the rules of the Michigan Board of Professional Surveyors or by a Decree of a Court of Law; established, re-established, monumented, re-monumented, recovered, found as expressed below:

NOTE: Not more than 4 corners, all in the same town and range, may be recorded on this certificate.

A. Description of original monument and accessories and/or subsequent restoration:

GLO Notes survey by L. Lyon, D.S. in 1827. Set Post in Swamp corner to Sections 11, 12, 13 and 14.
 9" Tamarack - S29-1/2°E - 31 links
 5" Tamarack - N13°W - 26 links
 (OVER)

B. Description of corner evidence found and/or method applied in restoring or reestablishing corner:


Found 1/2" rod in monument box. Accepted 1/4" rod as a careful and faithful reestablishment of the position of the original corner.

Set Standard Clinton County Monument and monument box.

C. Description of monument for corner and accessories established to perpetuate locating the position of the corner:

SW Corner, Section 12
 *Standard Clinton County Monument in monument box.

Nail & Tag #13039 in SW Side Power Pole - S56°E - 182.51'
 Face Stop Sign Post - N75°E - 32.89'
 Nail & Tag #13039 in SE Side Telephone Pole - S24°W - 97.57'
 Nail & Tag #13039 in NE Side Telephone Pole - N60°W - 39.02'
 *Standard Clinton County Monument is a 2 1/4" dia. steel tube 30" long with a stamped brass cap and a breakaway magnetic base.

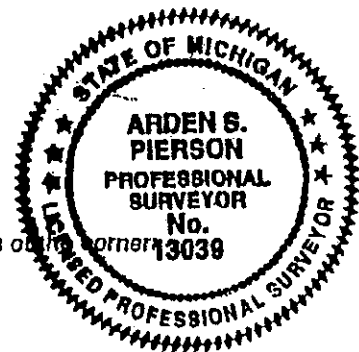

Signed by Arden S. Pierson Date October 16, 1995
 Surveyor's Michigan License No. 13039

APPROVED BY
 CLINTON COUNTY PEER GROUP
 DATED 10/18/95
6329

LCRC by Fred White #12034 dated June 6, 1972, Liber 1, Page 381.

Set corner by prorational measurement.
Railroad spike 6.35' North of Herbison Road on centerline
of Wright Road.

Telephone Pole - N50°00'E - 38.06'
Road Sign Post (2") - N70°30'E - 29.76'
Power Pole - S15°00'W - 97.53'

LCRC by James Stephens #16053 dated September 3, 1975, Liber 1,
Pages 967-968.

¼" iron rod in monument box was found in the centerline of
Herbison Road and Wright Road. Previous witnesses recorded
in Liber 1, Page 381, could not be found.

Survey tag on the NE Side of Utility Pole - S19°04'W - 97.68'
Survey tag on the NE Side of Utility Pole - N60°42'W - 38.05'
P.K. Nail with tag in center of 12" Concrete Post -
N52°23'E - 45.52'

Certified Boundary Survey by Arden Pierson #13039, dated
October 15, 1990, Liber 4, Pages 182-184.

Certified Boundary Survey by Richard Steadman #93044, dated
May 4, 1993, Liber 4, Page 746.

Found ¼" iron pipe in monument box.

Utility Pole - S19°W - 97.68'
Utility Pole - N60°W - 38.05'
Center of Concrete Post - N52°E - 45.52'

LCRC by Arden Pierson #13039 dated December 30, 1993, Liber 2,
Page 944.

Found ¼" rod in monument box.

Telephone Pole - N54°W - 38.62'
Telephone Pole - S24°W - 97.28'
Road Sign Post - N78°E - 33.00'