

JAN 27 2000

Clinton County Remonumentation  
East 1/4 Corner Section 1, T.5 N.-R.4 W., Eagle Township  
LAND CORNER RECORDATION CERTIFICATE  
Filing Requirement of Act 74, Mich. P.A. 1970

9/2

For corners in

Clinton \_\_\_\_\_ Located In: Corner Code #  
(County)

1. Public Land Survey T 5N R 4W M-2  
T \_\_\_\_\_ R \_\_\_\_\_  
T \_\_\_\_\_ R \_\_\_\_\_  
T \_\_\_\_\_ R \_\_\_\_\_

2. Property Controlling S \_\_\_\_\_ T \_\_\_\_\_ R \_\_\_\_\_  
in Section S \_\_\_\_\_ T \_\_\_\_\_ R \_\_\_\_\_

3. Miscellaneous S \_\_\_\_\_ T \_\_\_\_\_ R \_\_\_\_\_  
Property in Sec. S \_\_\_\_\_ T \_\_\_\_\_ R \_\_\_\_\_

LIBER 004 PAGE 369  
RECORDED  
DEC 21 12 57 PM '99  
REGISTER OF DEEDS  
CLINTON COUNTY, MICH.  
*Wendy Winkley*  
Register of Deeds Stamp & File Number

4. Lot No. \_\_\_\_\_, Recorded Plat \_\_\_\_\_  
5. Private Claims \_\_\_\_\_

I, Samuel J. Clark, in a field survey on November 16, 1999 do hereby state that under requirements of P.A. 74, Michigan P.A. of 1970, the corner points mentioned in lines 1 and 2 above were in conformance with regulations and rules therefore as required in the current manual of survey instructions of the United States Department of the Interior, Bureau of Land Management or by a decree of a Court of Law and/or that the corner points mentioned in lines 3, 4 and 5 above were in conformance with the rules of the Michigan Board of Land Surveyors or by a Decree of a Court of Law; established, re-established, monumented, recovered, found as expressed below:

	B	C	D	E	F	G	H	I	J	K	L	M
1												
2	6		5		4		3		2		1	
3												
4	7		8		9		10		11		12	
5												
6	18		17		16		15		14		13	
7												
8	19		20		21		22		23		24	
9												
10	30		29		28		27		26		25	
11												
12	31		32		33		34		35		36	
13												

NOTE: Not more than 2 corners, all in the same town and range, may be recorded on this certificate.

A. Description of original monument and accessories and/or subsequent restoration:

M-2 East 1/4 Corner, Section 1, Eagle Township  
Corner set February 1826 by Lucius Lyon, Deputy Surveyor with the following witnesses:  
8" Aspen N37°W, 22 lks. (14.52')  
8" Aspen S83°W, 22 lks. (14.52')

APPROVED BY  
CLINTON COUNTY PEER GROUP  
DATED 11/10/99  
*J. Clark*

(Over)

B. Description of corner evidence found and/or method applied in restoring or reestablishing corner:

M-2 East 1/4 Corner, Section 1, Eagle Township

Found Bar & Cap  
1/2" Rebar, North, 116.15'

Found Bar fits the proportionate location as intended by D. Ankrom. This corner accepted as a careful and faithful reestablishment of the position of the original corner.

C. Description of monument for corner and accessories established to perpetuate locating the position of the corner:

M-2 East 1/4 Corner, Section 1, Eagle Township


\*Set Standard Clinton County Monument

N & T #41096 N. Face 10" Ash, S86°W, 34.92'  
N & T #41096 E. Face 6" Ash, N11°W, 75.75'  
N & T #41096 SW Face 4" Ash, S42°E, 23.20'

\*Standard Clinton County Monument at A-2, South, 116.15'  
\*Standard Clinton County Monument at M-3, S.00°-08'-07"E., 2633.47'  
\*Standard Clinton County Monument at M-1, N.00°-08'-26"W., 2630.27'

Bearings based on a solar observation performed at M-1 Eagle Twp. on November 9, 1999

\*Standard Clinton County Monument being a 2 1/2" Diameter Steel Tube, 30" long, with a stamped brass cap, restamped #41096, and breakaway magnetic base.

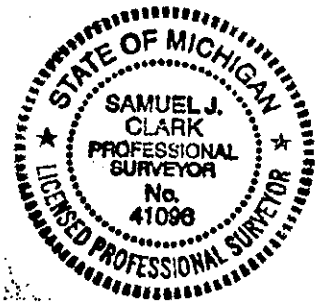

Signed by *Samuel J. Clark*  
Surveyor's Michigan License No. 41096

Date 12/20/99

- ◆ Certificate of Survey by Duane A. Ankrom, PS #21265, dated January 1977 and recorded in Liber 001, Page 869  
Set Bar & Cap by proration and on line with SE & NE Corners.  
24" Walnut, N80°W, 26.23'  
16" Walnut, N33°W, 60.28'  
Fence Post, West, 27.82'  
Angle Iron, N50°E, 20.21'

JAN 27 2000

SECTION

