

JAN 21 2000

SECTION

**Clinton County Remonumentation**  
**Northeast Corner Section 13 and Southeast Corner of Section 12,**  
**T.5 N.-R.4 W., Eagle Township**  
**LAND CORNER RECORDATION CERTIFICATE**  
**Filing Requirement of Act 74, Mich. P.A. 1970**

9/2

For corners in  
For corners in

LIBER 004 PAGE 375

RECORDED

DEC 21 12 57 PM '99

REGISTER OF DEEDS  
CLINTON COUNTY, MICH.

*Garret Woolley*

Register of Deeds Stamp & File Number

Clinton \_\_\_\_\_ Located In: \_\_\_\_\_ Corner Code # \_\_\_\_\_  
 (County)

1. Public Land Survey T 5N R 4W M-5  
 T \_\_\_\_\_ R \_\_\_\_\_  
 T \_\_\_\_\_ R \_\_\_\_\_  
 T \_\_\_\_\_ R \_\_\_\_\_

2. Property Controlling in Section S \_\_\_\_\_ T \_\_\_\_\_ R \_\_\_\_\_  
 S \_\_\_\_\_ T \_\_\_\_\_ R \_\_\_\_\_

3. Miscellaneous Property in Sec. S \_\_\_\_\_ T \_\_\_\_\_ R \_\_\_\_\_  
 S \_\_\_\_\_ T \_\_\_\_\_ R \_\_\_\_\_

4. Lot No. \_\_\_\_\_, Recorded Plat \_\_\_\_\_

5. Private Claims \_\_\_\_\_

	B	C	D	E	F	G	H	I	J	K	L	M
1												
2	6		5		4		3		2		1	
3												
4	7		8		9		10		11		12	
5												
6	18		17		16		15		14		13	
7												
8	19		20		21		22		23		24	
9												
10	30		29		28		27		26		25	
11												
12	31		32		33		34		35		36	
13												

I, Samuel J. Clark, in a field survey on November 16, 1999 do hereby state that under requirements of P.A. 74, Michigan P.A. of 1970, the corner points mentioned in lines 1 and 2 above were in conformance with regulations and rules therefore as required in the current manual of survey instructions of the United States Department of the Interior, Bureau of Land Management or by a decree of a Court of Law and/or that the corner points mentioned in lines 3, 4 and 5 above were in conformance with the rules of the Michigan Board of Land Surveyors or by a Decree of a Court of Law; established, re-established, monumented, recovered, found as expressed below:

NOTE: Not more than 2 corners, all in the same town and range, may be recorded on this certificate.

A. Description of original monument and accessories and/or subsequent restoration:

M-5 Northeast Corner Section 13 and Southeast Corner Section 12, Eagle Township  
 Corner set February 1826 by Lucius Lyon, Deputy Surveyor with the following witnesses:  
 26" Red Oak, S3°W, 28 lks. (18.48')  
 8" Sugar, N5°W, 11 lks. (7.26')

(Over)

APPROVED BY  
 CLINTON COUNTY PEER GROUP  
 DATED 11/10/99

*SJC*

B. Description of corner evidence found and/or method applied in restoring or reestablishing corner:

M-5 Northeast Corner Section 13 and Southeast Corner Section 12, Eagle Township

Found 5/8" iron rod over stone with plow points on E and W side  
 CC Remon. Tablet (A-5 Watertown Twp.), South, 107.74'  
 N & T #31603, East face 12" Locust, N35°W, 46.66'  
 N & T in Cons. Power Co., SW face P.P., S40°E, 47.04'  
 N & T in NW face P.P., S22°W, 114.88'


My research did not reveal County Surveyor Notes on the stone but these notes are referenced on Mr. Pierson's LCRC. I accept this corner as the careful and faithful perpetuation of the position of the original corner.

C. Description of monument for corner and accessories established to perpetuate locating the position of the corner:

M-5 Northeast Corner Section 13 and Southeast Corner Section 12, Eagle Township

\*Set Standard Clinton County Monument  
 N & T in NW face P.P., S22°W, 114.88'  
 N & T in Cons. Power Co., SW face P.P., S40°E, 47.04'  
 N & T #31603, East face 12" Locust, N35°W, 46.66'  
 \*Standard Clinton County Monument (A-5 Watertown Twp.), South, 107.74'  
 \*Standard Clinton County Monument at M-6 N.00°-27'-16"W., 2635.81'  
 \*Standard Clinton County Monument at M-4 S.00°-01'-18"E., 2630.83'  
 Bearings based on a solar observation performed at M-1 Eagle Twp. on November 9, 1999

\*Standard Clinton County Monument being a 2 1/2" Diameter Steel Tube, 30" long, with a stamped brass cap, restamped #41096, and breakaway magnetic base.

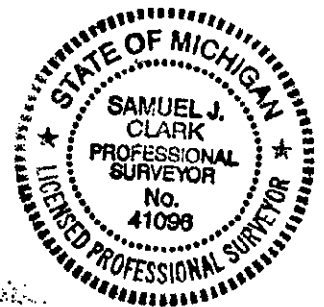

Signed by Samuel J. Clark  
 Surveyor's Michigan License No. 41096

Date 12/20/99

- ◆ Certificate of Survey by Arden S. Pierson, PS #13039, dated September 20, 1979 and recorded in Liber 2, Page 229  
5/8" Iron rod over pointed stone with plow points on E & W side  
P & T pole, S42°E, 46.98'  
T. Pole, S28°W, 84.84'  
2" Locust, N38°W, 47.10'  
5" Maple, N24°W, 68.21'
  
- ◆ LCRC by Arden S. Pierson, PS #13039, dated September 20, 1979 and recorded in Liber 2, page 268  
5/8" Iron rod over pointed stone with plow points on E & W side (a reference to County Surveyor Notes record - stone set)  
P & T pole, S42°E, 46.98'  
T. Pole, S28°W, 84.84'  
2" Locust, N38°W, 47.10'  
5" Maple, N24°W, 68.21'

JAN 21 2000

SECTION