(M 01 - T5N - R2W =)
A 13 - T6N - R1W - VICTOR TWP (RECORD # ~~78~~ 76)

FEB 2 2 1996
RECORDED

LAND CORNER RECORDATION CERTIFICATE

Filing Requirement of Act 74, Mich. P.A. 1970

JAN 24 9 45 AM '94
REGISTER OF DEEDS
CLINTON COUNTY, MICH.
Carol Wooley

LIBER 4, PAGE 3

Register of Deeds Stamp & File Number

For corners in Clinton (County)

	Located In:	Corner Code ##
1. Public Land Survey	T 5N R 2W	M-1, M-5
	T ___ R ___	
	T 6N R 1W	A-13
	T ___ R ___	
2. Property Controlling	S ___ T ___ R ___	
in Section	S ___ T ___ R ___	
3. Miscellaneous	S ___ T ___ R ___	
Property in Sec.	S ___ T ___ R ___	

4. Lot No. _____, Recorded Plat _____
5. Private Claims _____

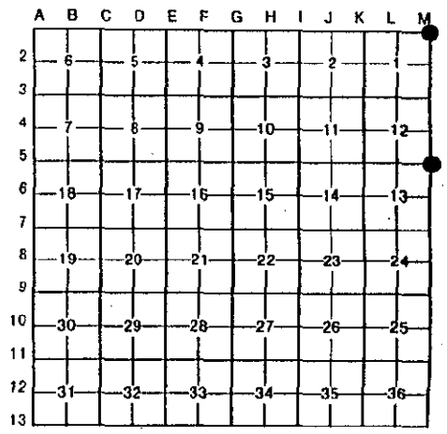

I, ~~Arden S. Pierson P.S.~~ on a field survey on October 10, 19 93, do hereby certify that under requirements of P.A. 74, Michigan P.A. of 1970, the corner points mentioned in lines 1 and 2 above were in conformance with regulations and rules therefore as required in the current manual of survey instructions of the United States Department of the Interior, Bureau of Land Management or by a decree of a Court of Law and/or that the corner points mentioned in lines 3, 4 and 5 above were in conformance with the rules of the Michigan Board of Land Surveyors or by a Decree of a Court of Law; established, re-established, monumented, re-monumented, recovered, found as expressed below:

NOTE: Not more than 4 corners, all in the same town and range, may be recorded on this certificate.

A. Description of original monument and accessories and/or subsequent restoration:

M-1 - County Surveyor notes - R.H. Colburn - December, 1883 found original corner established by Government Survey, recorded as ½" iron in monument box in Liber 1, page 657.

M-5 - County Surveyor notes - R.H. Colburn - September, 1884 found both corners ("24 links South of Dewitt corner") Recorded in Liber 1, page 97, by R. Lester P.S. on 8/13/75 "excavated, 4' deep and placed ½" rod at closing distance."

B. Description of corner evidence found and/or method applied in restoring or reestablishing corner:

Dewitt Township

M-1 - Found ½" rod in monument box, removed monument and excavated, found pointed stone 12" long next to ½" rod, removed ½" rod and stone and placed Standard Clinton County Monument and replaced monument box.

M-5 - Found ½" rod in Centerline of Chandler Rd.& Herbison Rd. West. Closing distance agrees with existing monumentation. Accepted as corner position and removed ½" rod and placed Standard Clinton County Monument and monument box.

C. Description of monument for corner and accessories established to perpetuate locating the position of the corner:

M-1 (Standard Clinton County Monument in monument box)	M-5 (Standard Clinton County Monument in monument box)
Tag #18989 S. side 36" Oak -S83°E- 36.65'	A-5(Bath Township) South- 15.84'
MSHD tag SE side power pole -S37°W- 57.49'	N & T NE side cut off pole -S60°E- 35.31'
MSHD tag S. 16" Hickory(clump) -N73°W- 29.70'	N & T NE side power pole -N53°W- 157.65'
N & T NE side 18" Cottonwood -N12°W- 81.70'	NE corner of North Tel. riser box -S60°W- 54.87'
	Face North post arrow sign -S80°E- 18.48'

**Standard Clinton County Monument is a 2" steel tube with a 2½" breakaway magnetic base and stamped brass cap

Signed by Arden S Pierson Date ~~November 24, 1993~~

Surveyor's Michigan License No. 13039

APPROVED BY CLINTON COUNTY PEER GROUP
DATED 12/4/93
9-7-9

FORM APPROVED BY MICHIGAN STATE BOARD OF LAND SURVEYORS, JAN. 28, 1971
REVISED MAY 14, 1976
REVISED JAN. 1993

Bath, A1

COMPUTER RECORD